

Name **Vernon Page**

Service No. **41**

Address **17 Tower Road**

**17 Tower Road**

Location **17 Tower Road**

Kind of Pipe

Size **6"**

Size of Main **8"**

~~Extended Service~~ **New Service**

Com. ~~8-22-49~~

Location

Date	Material	Amount	Total	Date	Amount
June 22, '49	Labor	11 30	11 30	June 8, '49	60 00
June 23, '49	Labor	33 22	33 22	Nov 17, '49	14 52
	10% Overhead		4 45		74 57
	48' - 6" Sewer Pipe @.265		12 72		
	1 - 6" Elbow		1 52	1-24-98	(Main Blockage - grease)
	Joint Compound		2 88	11-13-01	38' New Pipe Installed (No Info)
	Littlefield Shovel @7.00 1 Hr.		7 00		
	Trucking 2 hrs. @.75		1 50		
			74 59		
	<i>Bill sent 10-11-49</i>				
	Labor				



# TOWN OF LEXINGTON—DEPT. OF PUBLIC WORKS

## SEWER DIVISION

DATE .....

NO. ....


The undersigned applies for the construction of a particular sewer connecting No. .... Street and hereby agrees to comply with the Rules and Regulations governing the construction and use of Particular Sewers, as now or at any future time established by the Board of Selectmen.

Am't of estimate \$.....

Am't Paid \$.....

..... Owner

Sketch of Service Here

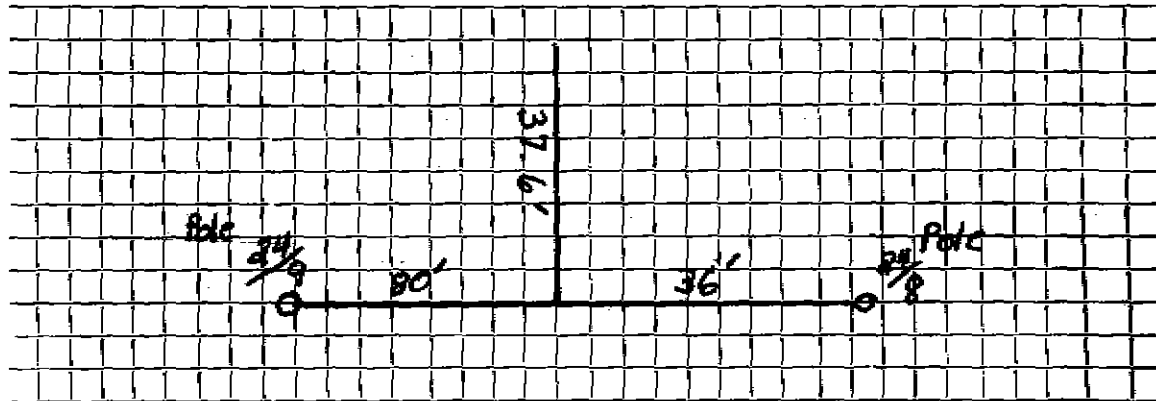

Connection made in ..... Street.

Work completed ..... 19..

Remarks: