

Name William B. ...

Service No. 11772

Address 2.5 tower road

**Note:** This cost is for services only, and location is subject to go to cost of extension is correct

2.5 Tower Road

Kind of Pipe \_\_\_\_\_ Size 6" Size of Main 8"

~~XXXXXXXXXXXX~~ - New Service

Location \_\_\_\_\_

Date	Material	Amount	Total	Date	Amount
11-15-30	110# 6" sewer pipe @ .30	33.00			
for 150.00	Sulphur & Jute	4.40		April 7	1230 - Cash
	Trucking	75			
	4 Yrs. Pump.	10.00			
	1 Stick Dyn.	50			
	3 Caps @ .14	42	49.07		
5/17/30	Mrs. Labor @ .55	44.00			
18 "	" @ .60	7.20	51.20		
	15% Overhead	7.68			
			107.88		
	Labor				

TOWN OF LEXINGTON—BOARD OF PUBLIC WORKS

SEWER DIVISION

DATE March 24/30

NO. Town St.


The undersigned applies for the construction of a particular sewer connecting No. Town St. Street and hereby agrees to comply with the Rules and Regulations governing the construction and use of Particular Sewers, as now or at any future time established by the Board of Selectmen.

Am't. of Estimate \$ \_\_\_\_\_

Am't. Paid \$ \_\_\_\_\_

Hilson E. Leighton Owner

Sketch of Service Here

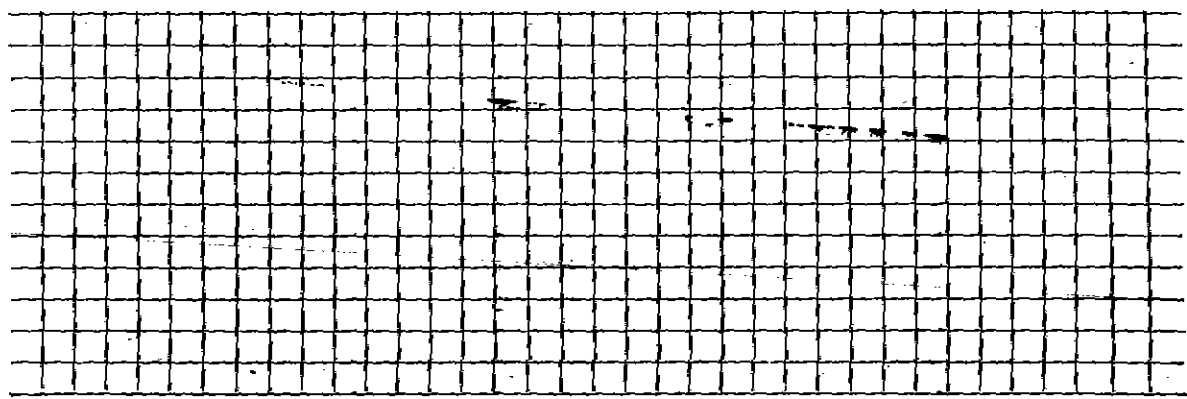

Connection made in \_\_\_\_\_ Street. Work completed \_\_\_\_\_ 19

Remarks: