

Name Mac L & B Realty Co.

Service No. 102

Address 32 Tower Road

32 Tower Road

Location

Kind of Pipe

Size 6"

Size of Main 8"

Rep. ~~REPAIR~~ — New Service W.O. # 9080

DeFlac # 1753

Location DEC 31 1970


Date	Material	Amount	Total	Date	Amount
11/5/70	Labor		56 75	11-14-70	Deposit 150 00
	10% O.H		5 68	1-18-71	Retard 49 12
23'	6" Transite pipe .90		20 70		100 88
1	Hr. Trucking		3 00		
1½	Hrs. Shovel 6.50		9 75		
1	Hr. Loader		5 00		
			100 88		
11-10-70	21' 6" Transite pipe			4-3-05	Main Blocked
	11' 4" Cast Iron pipe				48'+54' up from Locust st
					M.H. at

DATE _____

TOWN OF LEXINGTON — BOARD OF PUBLIC WORKS

SEWER DIVISION

Sketch of Service Here **32**

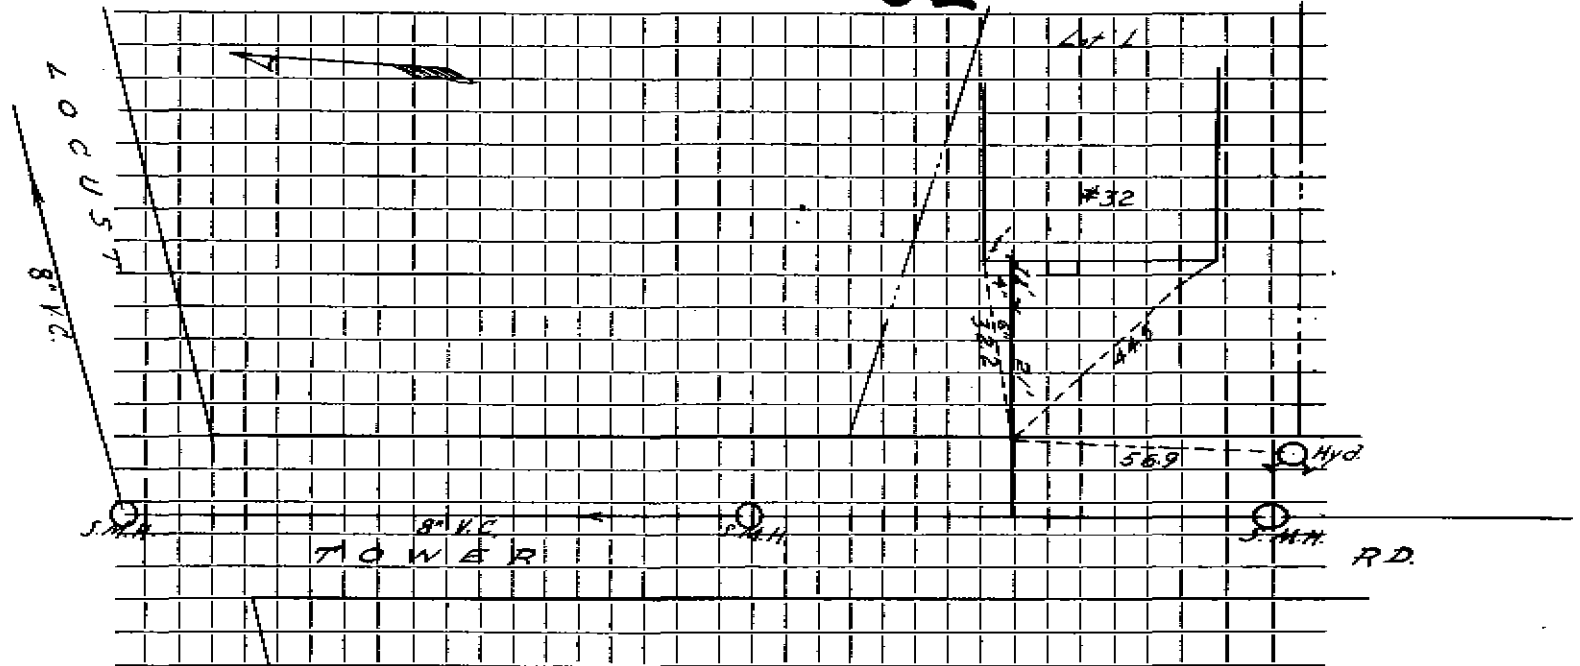

Connection made in Street. Work completed

Remarks:
.....
.....

A.V.E.