

Name

Service No.

Address

33 Tower Rd.

33 Tower Road  
Lexington

Location

Kind of Pipe

Size 6"

Size of Main 8"

Repair

~~XXXXXXXXXXXX~~~~To be charge to service when completed~~

Location

Date	Material	Amount	Total	Date	Amount
7-31-28					
	26' 4" Sewer Pipe				
	2 1/8" Bends				
	1 6"X4" Reducer				
					NON CHARGE
				5/25/53 Labor	37 33
				5/26/53 Labor	54 17
				24'-6" Sewer Pipe @.342	8 21
				Joint Compound	1 44
				8 Hr. Littlefield Shovel@7.50	60 00
				4 Hr. Trucking @.75	3 00
					164 15
	Labor				

**TOWN OF LEXINGTON—DEPT. OF PUBLIC WORKS  
SEWER DIVISION**

DATE.....

NO. ....


The undersigned applies for the construction of a particular sewer connecting No.....  
Street and hereby agrees to comply with the Rules and Regulations governing the construction and use of Particular  
Sewers, as now or at any future time established by the Board of Selectmen.

Am't of estimate \$.....

Am't Paid \$.....

..... Owner

**Sketch of Service Here**

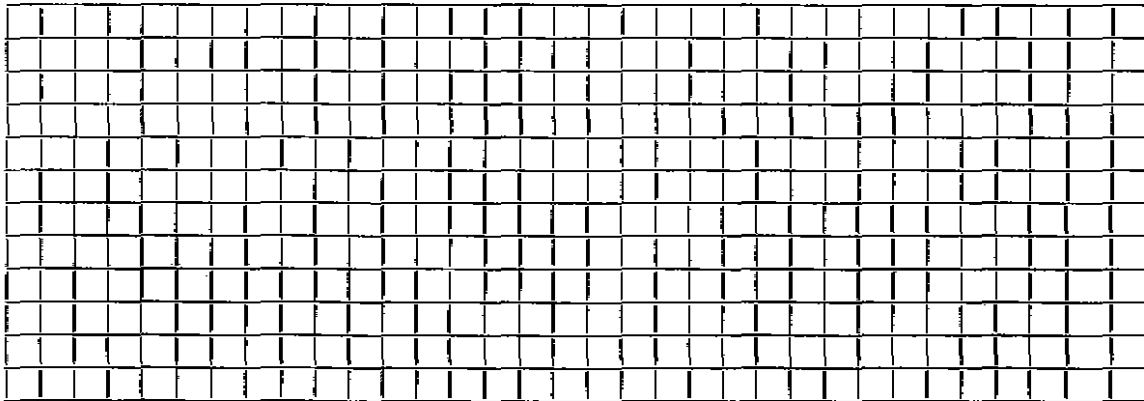

Connection made in..... Street.

Work completed..... 19..

Remarks: