

Name Mac L & B Realty Trust

Service No. 103

Address 34 Tower Road

34 Tower Road

Location

Kind of Pipe

Size 6"

Size of Main 8"

~~Revised~~ ~~Amended~~ ~~Order~~ ~~for~~ ~~New~~ ~~Service~~ W.O. # 9078 Ref # 1752

Location DEC 31 1970


Date		Material	Amount	Total	Date		Amount
11/4/70		Labor		99 85	10-14-70	Deposit	150 00
		10% O.H.		9 99	1-18-71	Paid by W.O. # 50	4 49
	20'	6" Transite pipe	90	18 00			154 49
	1/2	Bag cement	1.80	90			
	1	Hr. Trucking		3 00			
	3 1/2	Hrs. Shovel	6.50	22 75			
				154 49			
1-10-70	36'	6" Transite pipe					
	11'	4" Cast Iron pipe					

DATE _____

TOWN OF LEXINGTON — BOARD OF PUBLIC WORKS

SEWER DIVISION

Sketch of Service Here **34**

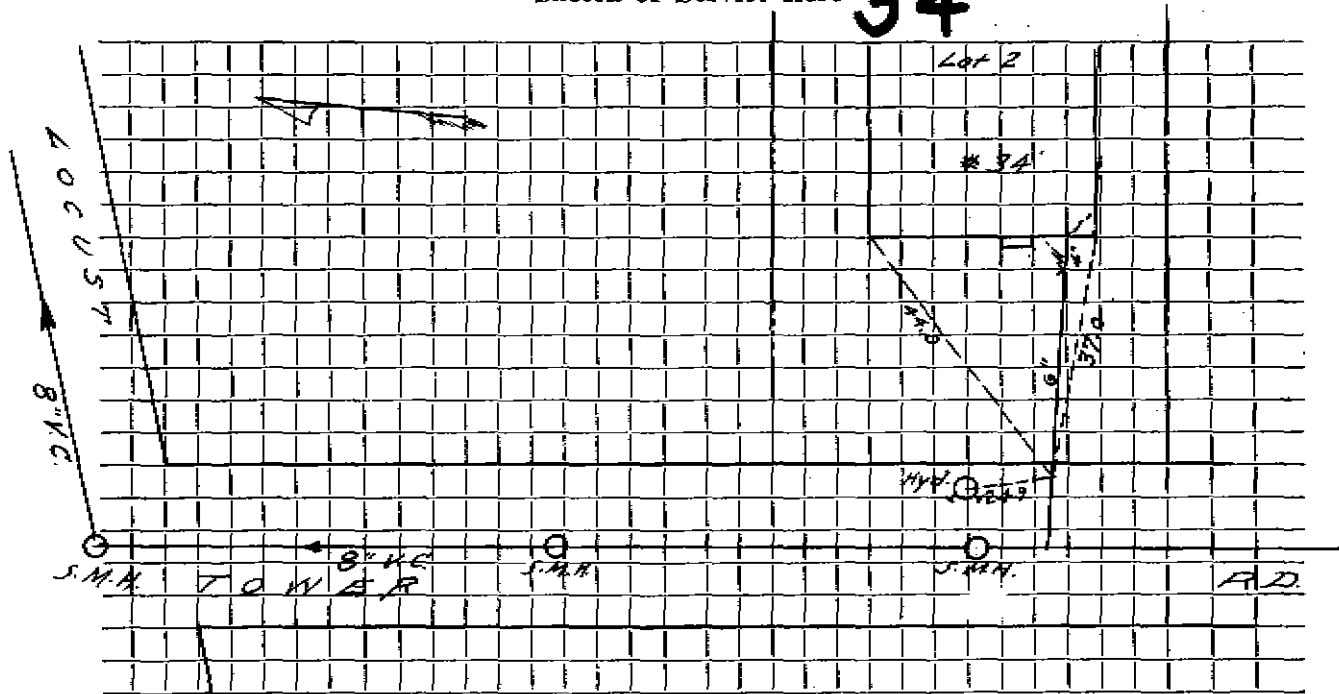

Connection made in Street. Work completed

Remarks:

.....

.....