

Name **Arthur Bennett**

Service No. **132**

Address **36 Tower Road**

Lexington, Mass.

Location **36 Tower Road**

Kind of Pipe

Size **6"**

Size of Main **8"**

~~Repair/Replacement~~ **New Service**

Location

Date	Material	Amount	Total	Date	Amount
Dec. 7, '48	Labor	3 35	3 35	Dec. 26, '48	Deposited 125 00
" 8 "	" "	23 54	23 54	Dec. 31, '48	Refunded 52 1/2
	10% Overhead		2 69		72 52
	42'-6" Sewer Pipe @ .26		10 92		
	Joint Compound		2 62		
	4 hrs. Littlefield, Shovel		28 00		
	2 hrs. Trucking		1 50		
			<u>72 52</u>		
	Labor				

TOWN OF LEXINGTON—DEPT. OF PUBLIC WORKS
SEWER DIVISION

DATE

NO.


The undersigned applies for the construction of a particular sewer connecting No.
Street and hereby agrees to comply with the Rules and Regulations governing the construction and use of Particular
Sewers, as now or at any future time established by the Board of Selectmen.

Am't of estimate \$.....

Am't Paid \$.....

..... Owner

Sketch of Service Here

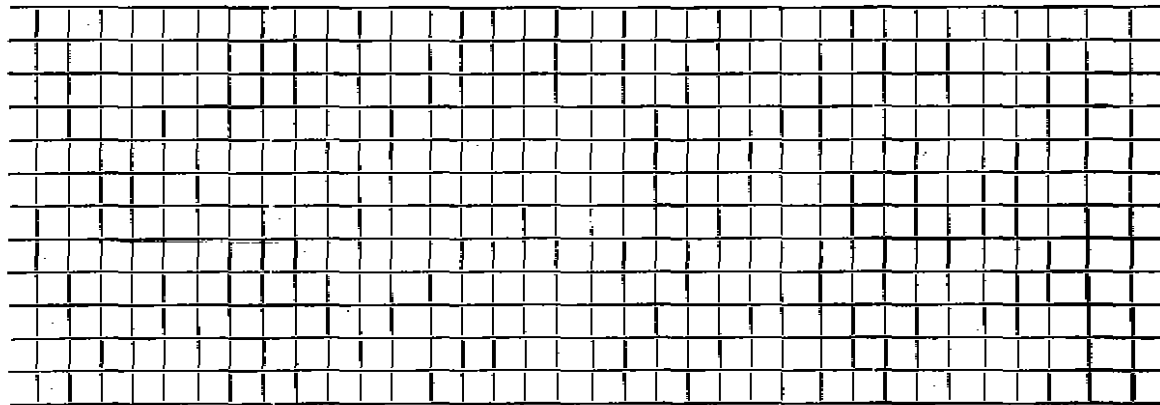

Connection made in Street.

Work completed 19..

Remarks: