

Name **N. Bowman Judkins**City **H. N. Crystalline**Service No. **776**Address **6 Colony Road #37 Tower Rd.**Deposit by **Judkins.**Location **#37 Tower Road (1st on right off Locust.)**

Kind of Pipe

Size **6"**Size of Main **8"**~~REPAIR SERVICE~~ **New Service**

Location

Date 1937	Material	Amount	Total	Date	Amount
Feb. 20	258 hrs. @ 55¢	141 90		2-9-37	Deposited 76.00
Com 3-9-37	Overhead	14 19	156 09	4-27-37	Paid 121.89
	55' 6" Sewer Pipe @ 20¢		11 00		197 89
	Jointing Compound		2 80		
	Trucking		2 00		
	Compressor- 6 hrs. @ 3.00		18 00		
	Tractor - 4 hrs. @ 2.00		8 00		
			197 89		
					Bill sent 3-10-37 121.89
	Labor				

Hidley Press, Inc., Lexington

TOWN OF LEXINGTON—BOARD OF PUBLIC WORKS
SEWER DIVISION

DATE Feb 12, 1937

NO. _____


The undersigned applies for the construction of a particular sewer connecting No. Tower Rd.
Street and hereby agrees to comply with the Rules and Regulations governing the construction and use of Particular
Sewers, as now or at any future time established by the Board of Selectmen.

Am't. of Estimate \$ _____

Am't. Paid \$ _____

H. W. Crigdenwise Owner
By M. B. Jenkins

Sketch of Service Here **37**

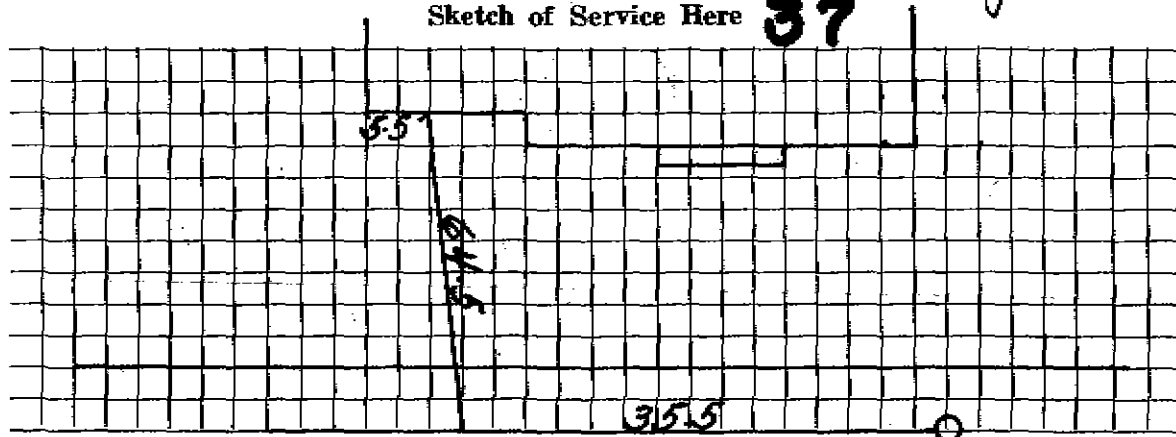

Connection made in _____ Street.

Work completed _____ 19

Remarks: