

Name Mr. Paul Fulton

Service No. 126

Address 6 Tower Road

6 Tower Road

Location

Kind of Pipe

Size 6"

Size of Main 8"

Renewal ~~RENEWAL~~ W. O. # 8330

Location APR 26 1972


Date	Material	Amount	Total	Date	Amount
12/10/71	Labor	64 18		12-18-71	216 00
12/22/71	"	31.16	95 34	4-24-72	56 23
	10% O.H.		9 53		159 77
	26' 6" Transite pipe .90		23 40		
	4 Yds. Loam 3.50		14 00		
	2 Hrs. Shovel 6.50		13 00	12/10/71	
	1 Hr. Truck		3 00	18'	Labor 83 29
	1 Hr. Truck		1 50	1	6" Transite pipe .90 18 20
			159 77	4	Ton cold patch 8 00
				4	Ton hot top 7.45 29 80
				1	Yd. Loam 3 50
				2	Hrs. Shovel 4.00 8 00
				1	Hr. Truck 3 00
					151 79

DATE _____

TOWN OF LEXINGTON — BOARD OF PUBLIC WORKS

SEWER DIVISION

Sketch of Service Here **6**

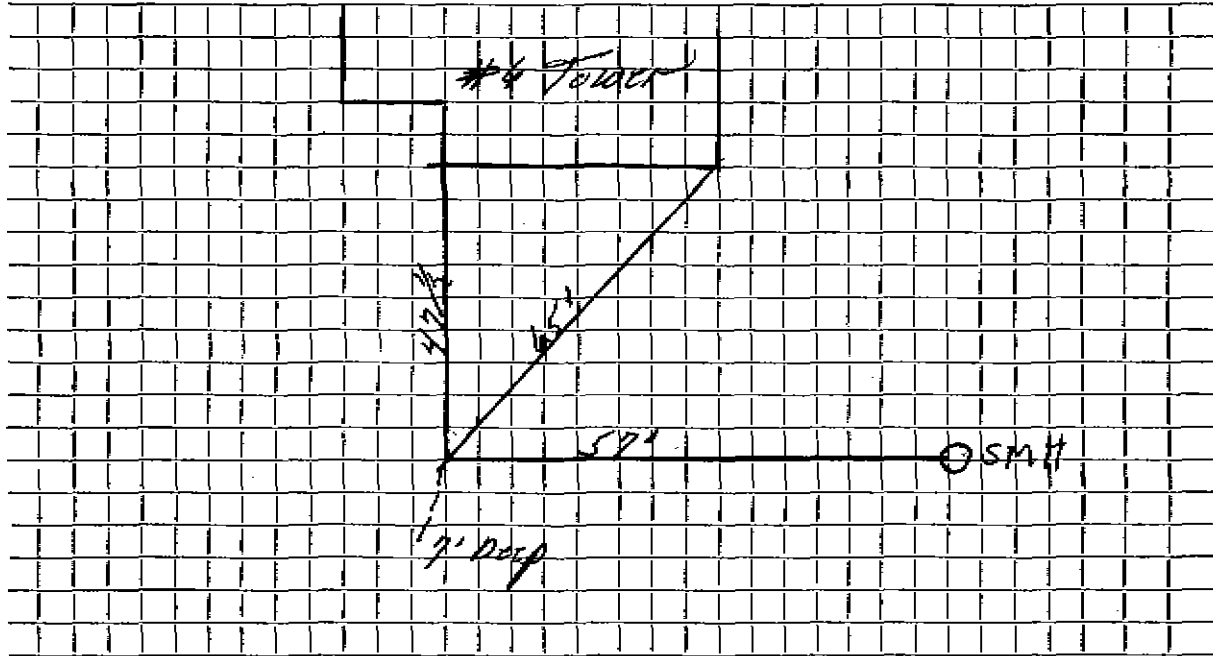

Connection made in Street. Work completed

Remarks:

.....

.....