

Name Dr. Connors

Service No.

Address 10 Tricorne Road

10 Tricorne Road

Location

Kind of Pipe

Size 6"

Size of Main 8"

Repair—Renewal—New Service

DeFlice #2578


Location

Date		Material	Amount	Total	Date	Amount
10/25/74	32'	6" Transite Pipe				
	10'	4" Cast Iron Pipe				

DATE 8/6/76

TOWN OF LEXINGTON — BOARD OF PUBLIC WORKS
SEWER DIVISION

Sketch of Service Here **10**

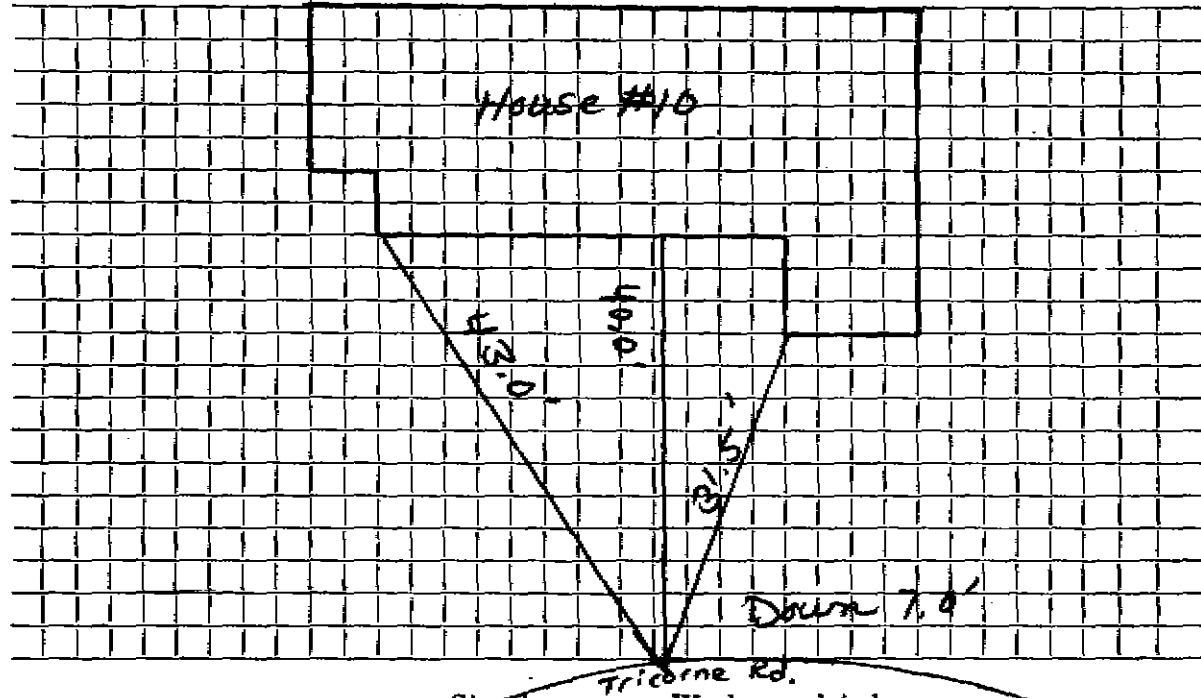

Connection made in Street. Work completed

Remarks:
.....
.....