

Name Louis Stolico

Service No.

Address 9 Tricorn Road

9 Tricorn Road

Location

Kind of Pipe

Size 6"

Size of Main 8"

Repair—Renewal—New Service Eagle #1271


Location

Date	Material	Amount	Total	Date	Amount
12-9-68	62' 6" Transite pipe				
	10' 4" Cast Iron pipe				

TOWN OF LEXINGTON — BOARD OF PUBLIC WORKS

SEWER DIVISION

Sketch of Service Here **9**

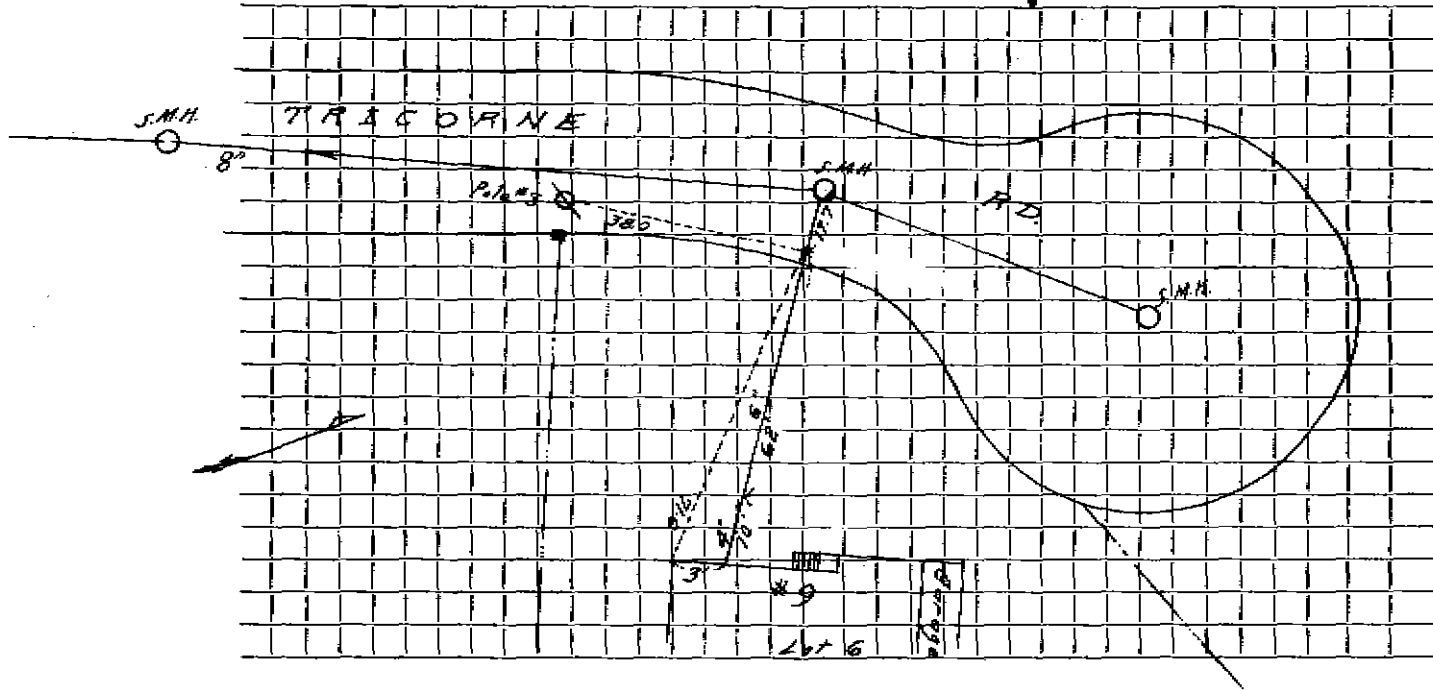

Connection made in ..... Street. Work completed .....

Remarks: .....  
.....  
.....