




DATE \_\_\_\_\_

TOWN OF LEXINGTON — BOARD OF PUBLIC WORKS

SEWER DIVISION

LOT #12 TROODEN PATH NO 1

Sketch of Service Here

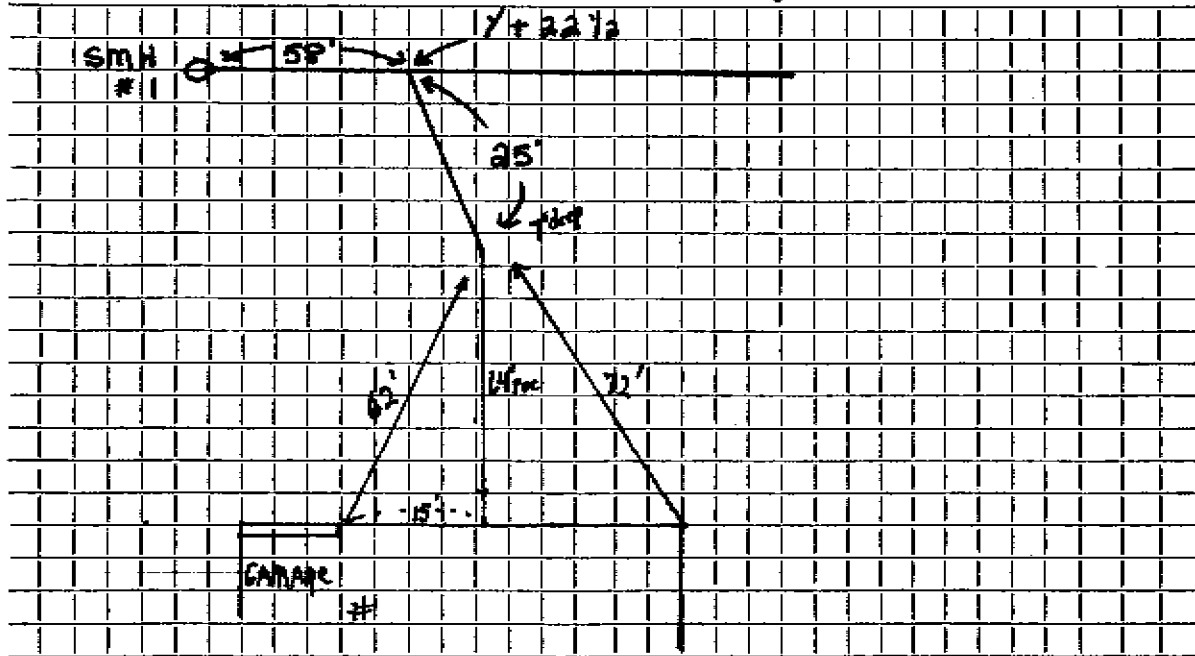

Connection made in ..... Street. Work completed .....

Remarks: .....

.....  
.....