




DATE \_\_\_\_\_

TOWN OF LEXINGTON — BOARD OF PUBLIC WORKS

SEWER DIVISION

LOT # 5 TRODDEN PATH NO 10

Sketch of Service Here **10**

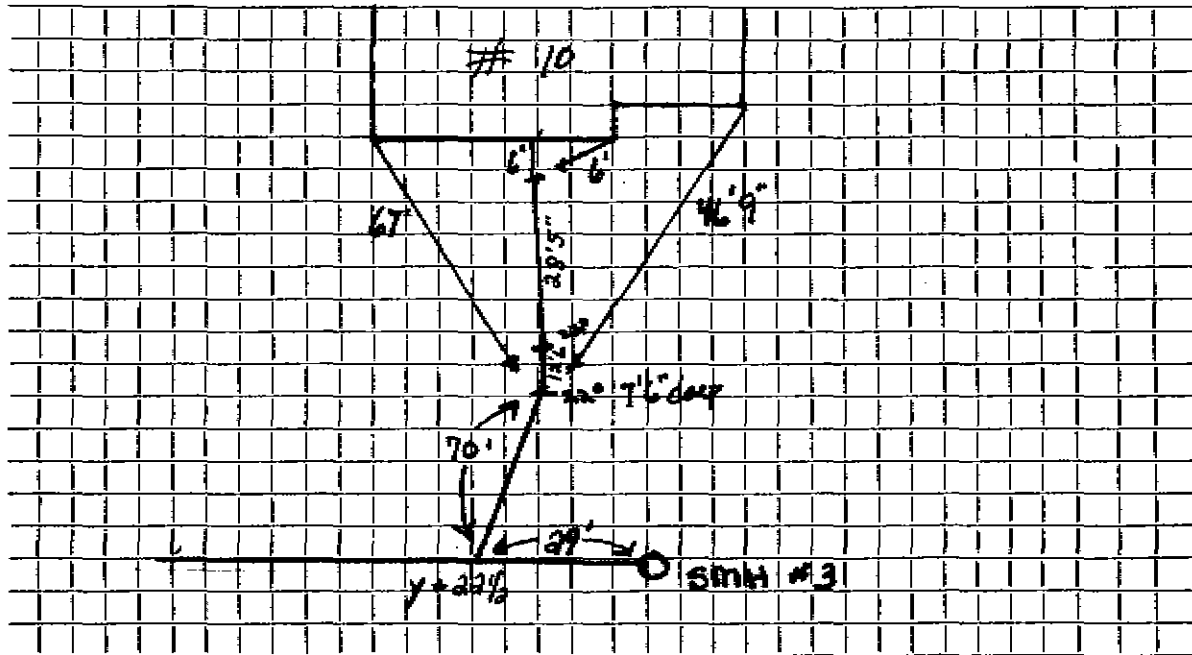

Connection made in ..... Street. Work completed .....

Remarks: .....  
.....  
.....