


DATE _____

TOWN OF LEXINGTON — BOARD OF PUBLIC WORKS

SEWER DIVISION

Lot # 6

Sketch of Service Here **12**

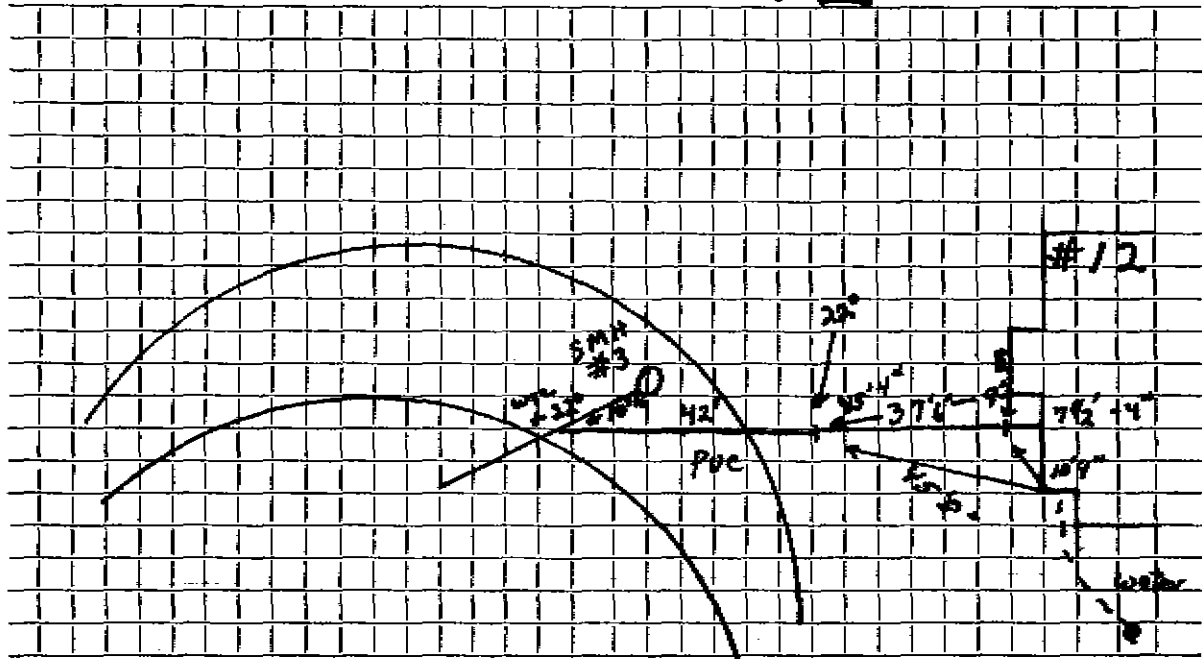

Connection made in Toddew Path Street. Work completed

Remarks:
.....
.....