


DATE _____

TOWN OF LEXINGTON — BOARD OF PUBLIC WORKS

SEWER DIVISION

LOT #1 TRODDEN PATH NO 2

Sketch of Service Here **2**
LOT #1

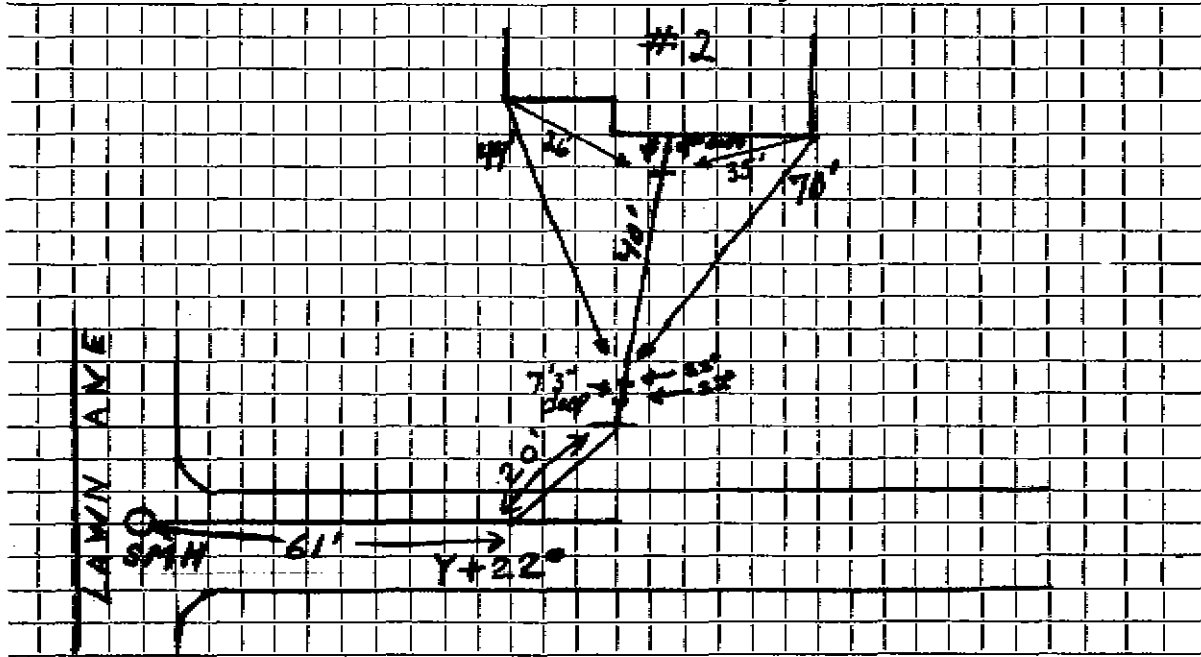

Connection made in Street. Work completed

Remarks:

.....

.....