

DATE _____


TOWN OF LEXINGTON — BOARD OF PUBLIC WORKS

SEWER DIVISION

LOT # 11 TRODDEN PATH No 3

Sketch of Service Here

3

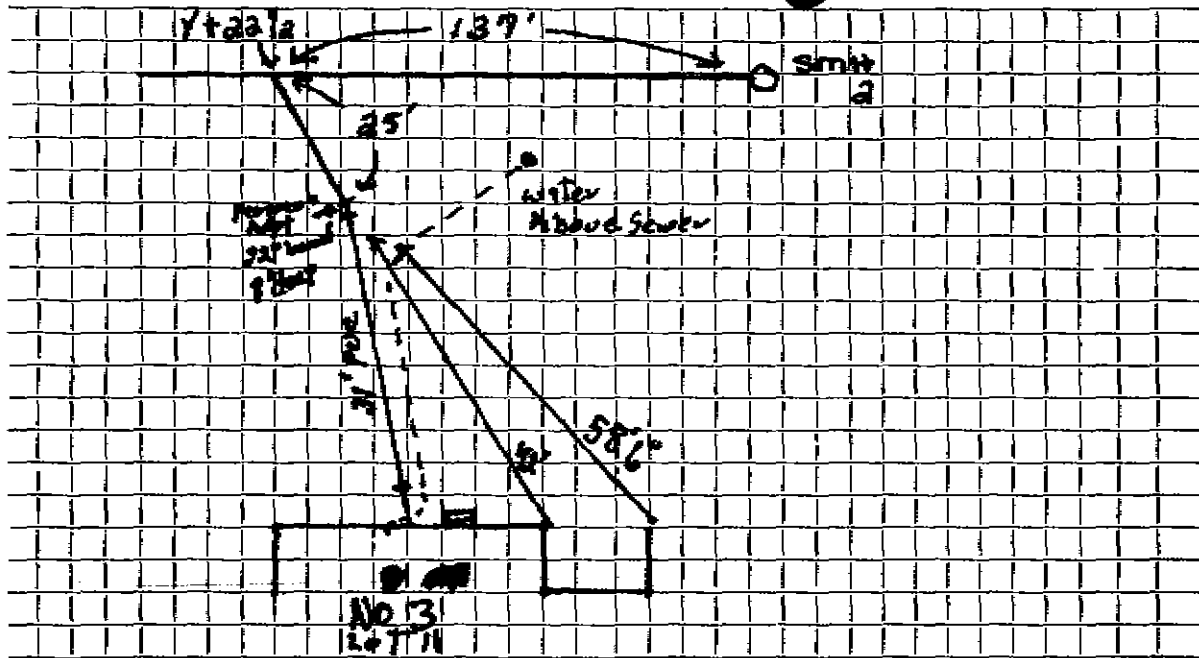

Connection made in Street. Work completed

Remarks:

.....

.....