


TOWN OF LEXINGTON — BOARD OF PUBLIC WORKS

SEWER DIVISION

LOT 2 TRODDEN PATH No-4

Sketch of Service Here **4**

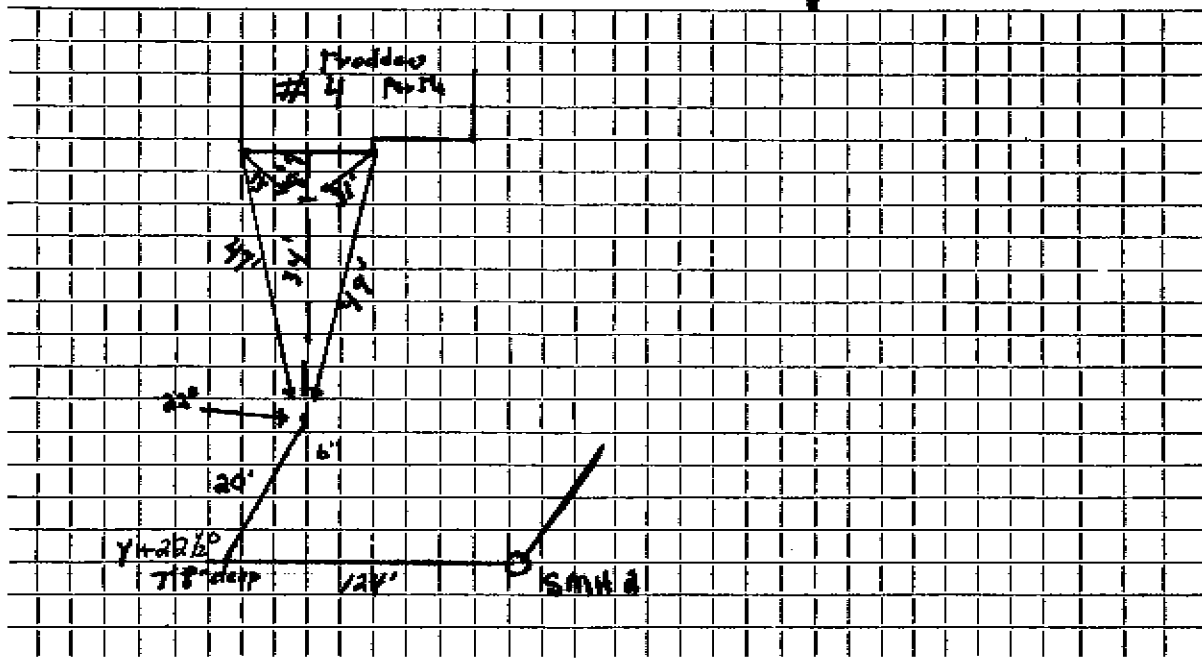

Connection made in Street. Work completed

Remarks:

.....

.....