


TOWN OF LEXINGTON — BOARD OF PUBLIC WORKS

SEWER DIVISION

DATE _____

Sketch of Service Here
Lot 10 No-5

5

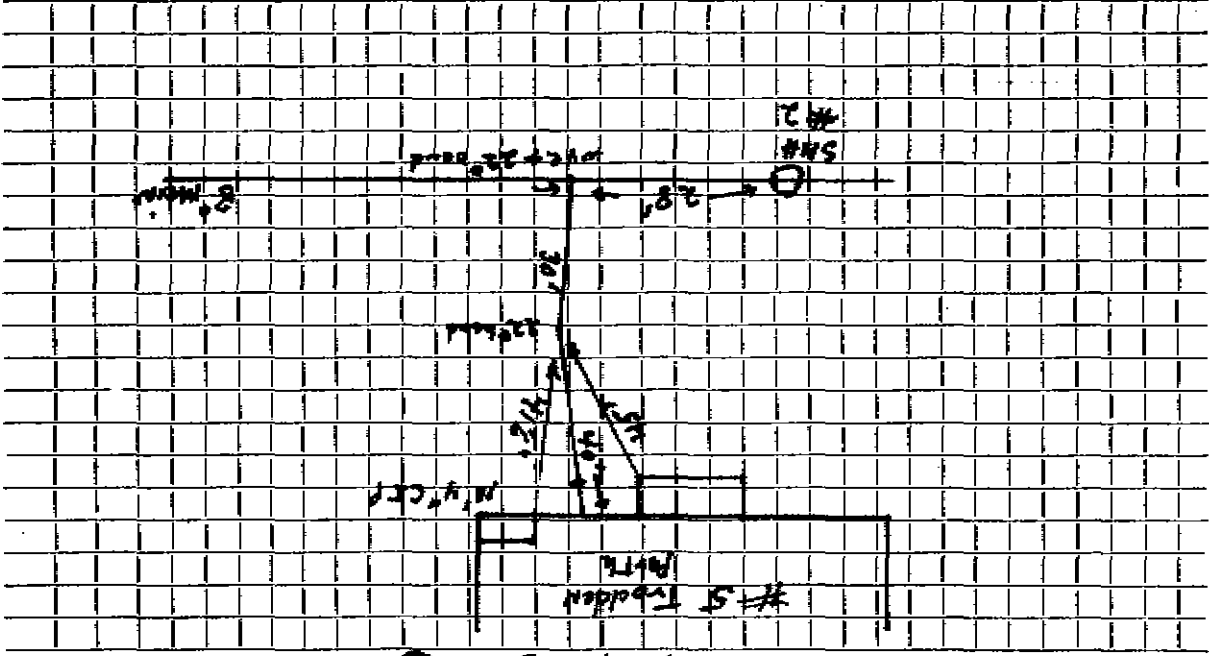

Work completed

Street

Connection made in

Remarks: