


DATE JUNE 1983

TOWN OF LEXINGTON — BOARD OF PUBLIC WORKS

SEWER DIVISION

Lot #3 TRODDEN PATH NO 6

Sketch of Service Here **6**

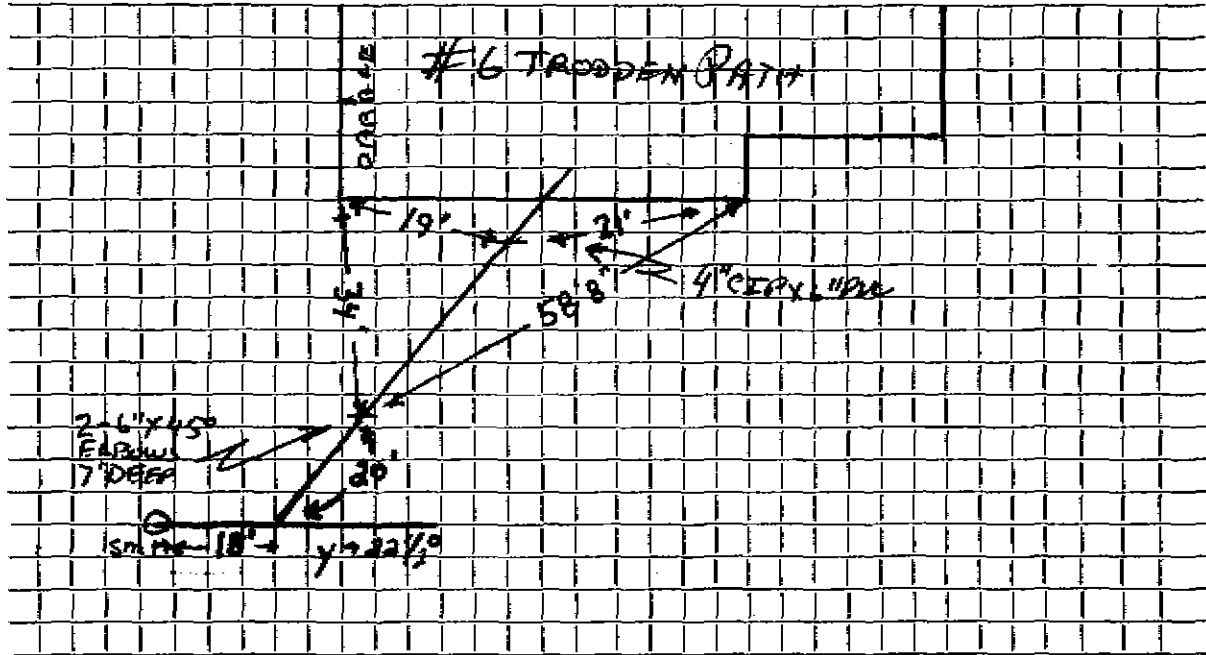

Connection made in TRODDEN PATH Street. Work completed JUNE 10, 1983

Remarks:

.....

.....