


DATE _____

TOWN OF LEXINGTON — BOARD OF PUBLIC WORKS

SEWER DIVISION

LOT #8 TRODDEN PATH NO 9

Sketch of Service Here **9**

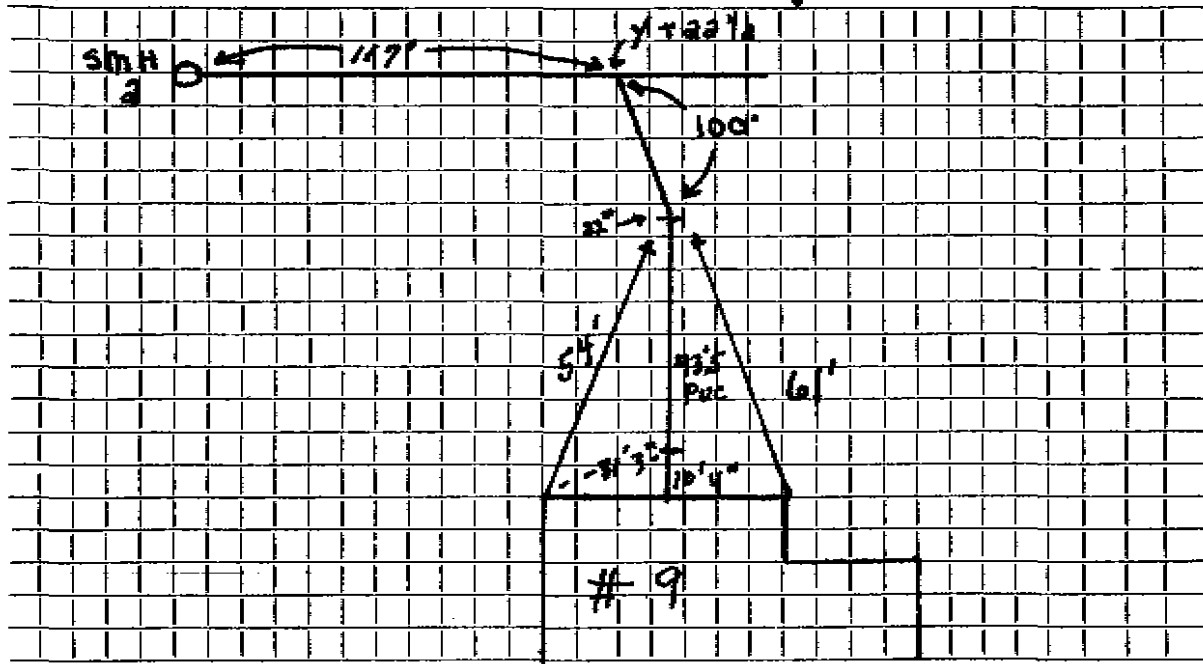

Connection made in Street. Work completed

Remarks:

.....

.....