




TOWN OF LEXINGTON — BOARD OF PUBLIC WORKS

SEWER DIVISION

DATE Oct 1983

Sketch of Service Here //

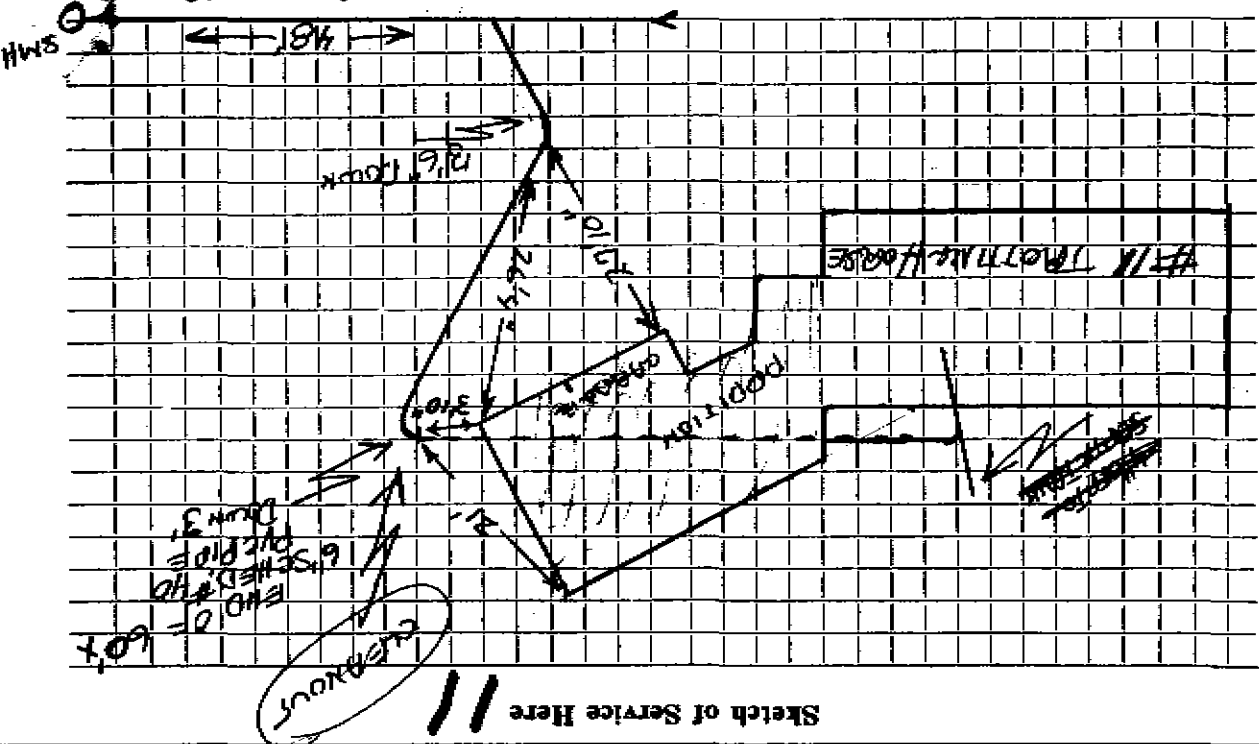

Connection made in Street.

Work completed APRIL 1985

Remarks: 60"X6" PVC PIPE INSTALLED UNDER ADDITION FOR FUTURE SEWER HOOD UP