

Name Caesar Briefer

Service No. 38

Address #15 Trotting Horse Drive

15 Trotting Horse Drive

Location

Kind of Pipe Valeri Const. Co.

Size 6"

Size of Main 8"

~~Repair - Renewal~~ - New Service Permit #262 W.O. # 137

Location MAY 17 1965


Date		Material	Amount	Total	Date	Amount
1964	22'	6" Transite pipe @	7.00		4-22-65	154.00
		installed by contractor		154.00	Deposit	
5-7-65	35'	6" Transite pipe				
		22' @ \$7				

DATE _____

TOWN OF LEXINGTON — BOARD OF PUBLIC WORKS
SEWER DIVISION

Sketch of Service Here

15

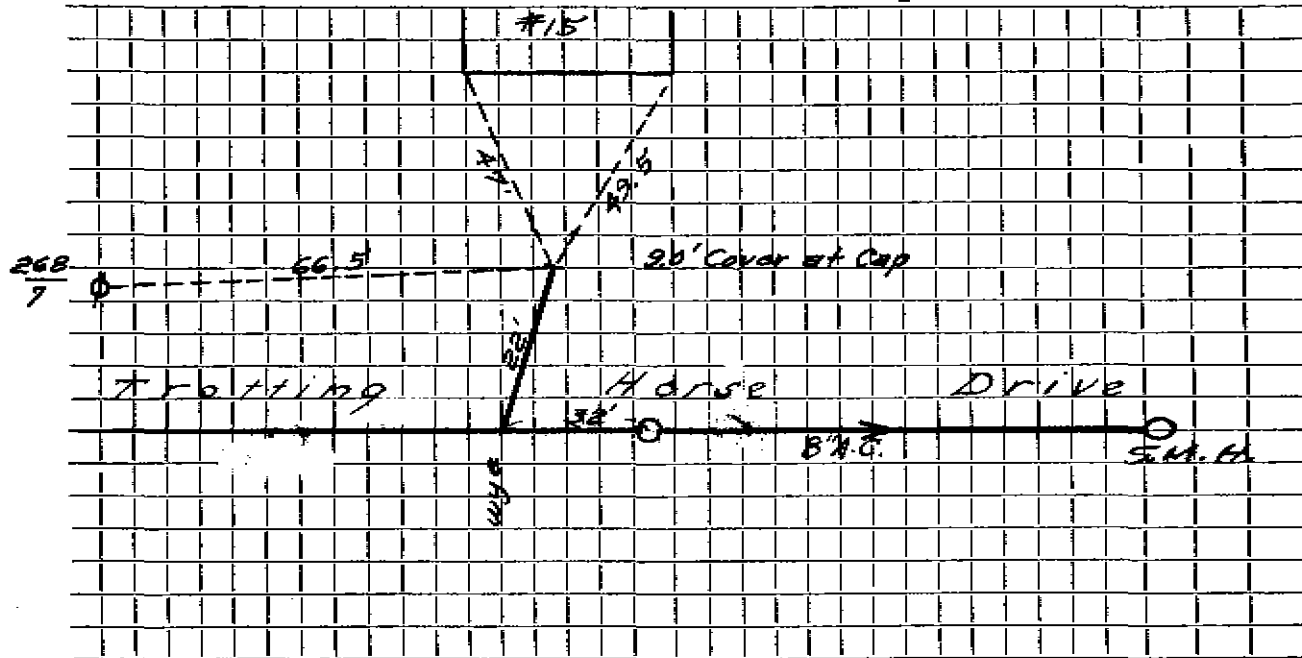

Connection made in Street. Work completed

Remarks:
.....
.....