

Name Lucille Glasberg

Service No. 202 (864)

Address #17 Trotting Horse Drive

17 Trotting Horse Drive

Location

Kind of Pipe

Size 6"

Size of Main 8"

Repair—Renewal—New Service

Location Conn #344

Date	Material	Amount	Total	Date	Amount
1964	43' 6" Sewer pipe installed by contractor @7.00 per Ft.		301.00	12-9-64	301.00
1-13-67	53' 6" Transite pipe				
	10' 4" Cast Iron pipe				
	43' @ \$7				


DATE _____

TOWN OF LEXINGTON — BOARD OF PUBLIC WORKS

SEWER DIVISION

Sketch of Service Here

17

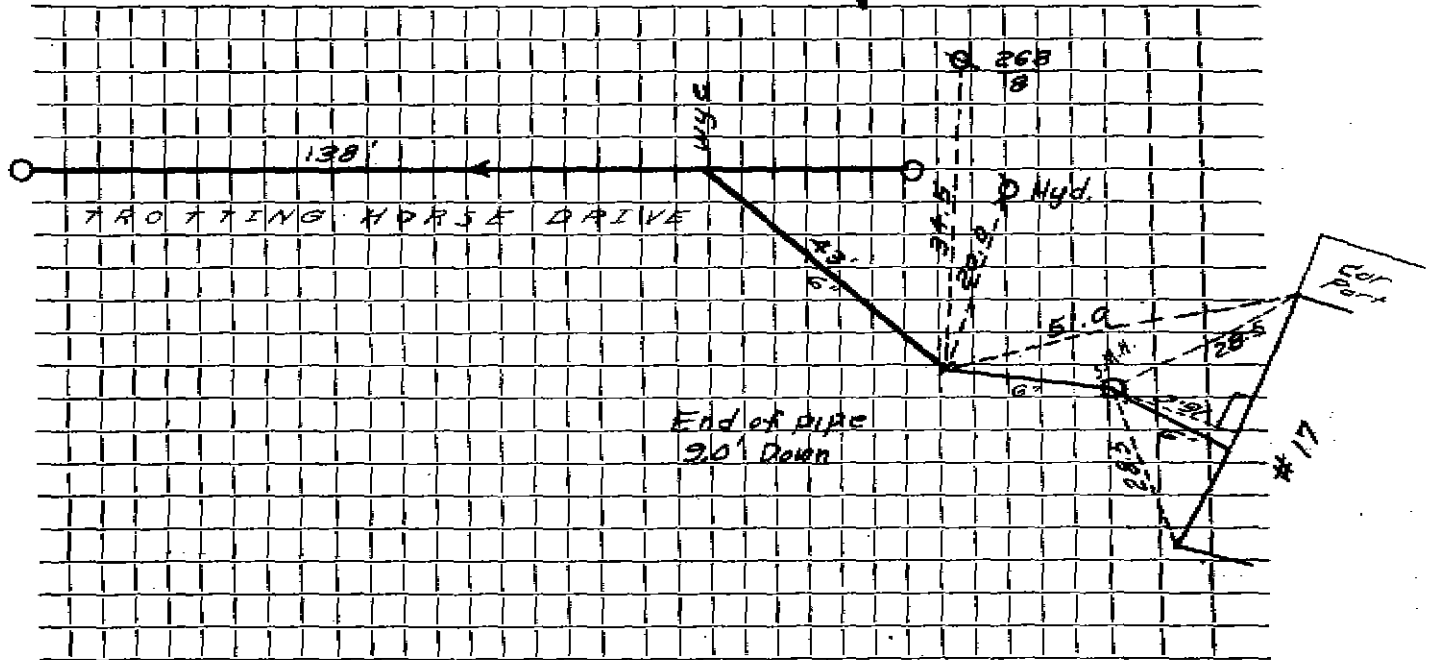

Connection made in Street. Work completed

Remarks:

.....

.....