

Address 12 Tucker Avenue, Lexington

12 Tucker Avenue

Location

Kind of Pipe

Size 6"

Size of Main 8"

Work Done - New Service

Location

Date
1943

Date	Material	Amount	Total	Date	Amount
MAY 11	39 hrs. @ 65¢	25 35		Apr 2, 1943	80 00
May 6/43	28 " @ 70¢	19 60		Apr 10, 1943	57 44
	17 " @ 80¢	13 60	58 55		74 06
	10% Overhead		5 86		
	34' 6" Sewer Pipe @ 16¢		5 44		
	1 6" 1/8 Bend		67		
	Jointing compound		2 04		
	Trucking - 2 hrs. @ 75¢		1 50		
			74 06		
	Labor				

TOWN OF LEXINGTON—BOARD OF PUBLIC WORKS

SEWER DIVISION

DATE April 2, 1943

NO. _____

The undersigned applies for the construction of a particular sewer connecting No. 12 Tucker Ave. Street and hereby agrees to comply with the Rules and Regulations governing the construction and use of Particular Sewers, as now or at any future time established by the Board of Selectmen.

Am't. of Estimate \$ 10⁰⁰


Anthony Janusas

Am't. Paid \$ _____

X *Anthony Janusas* Owner

Sketch of Service Here

12

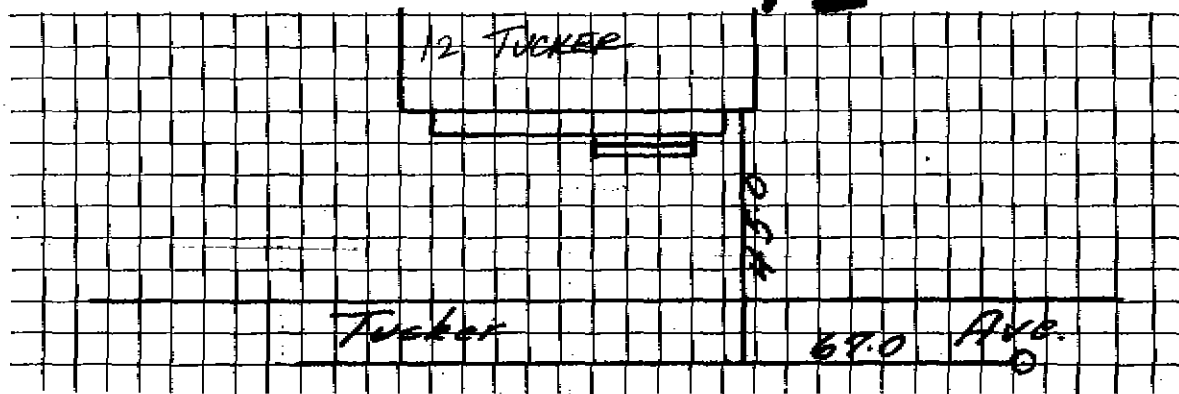

Connection made in _____ Street.

Work completed _____ 19

Remarks: