

Name Bernard C. Maloney

Service No. 70

Address 15 Tucker Ave.

15 Tucker Avenue

Location

Kind of Pipe

Size 6"

Size of Main 8"

Repair—Renewal—New Service W.O.#7283 Lucente #1165


Location NOV 18 1968

Date	Material	Amount	Total	Date	Amount	
8/27/68	Labor	76 60		8-26-68	Deposit	300 00
8/28/68	"	41 64		11-18-68	Refund	123 61
	10% O.H.	11 82	130 06			197 39
30'	6" sewerpipe @ .88		26 40			
1	8x6 saddle		5 50			
1	6" nipple		1 89			
1	90° elbow		4 09			
1	Bag cement		1 55			
20	Bricks		90			
1½	Hr. trucking @ 3.00		4 50			
1½	" " @ 1.50		2 25			
2½	" shovel @ 6.50		16 25			
1	" loader		4 00			
9-4-68	10' 4" Cast Iron 26' 6" Transite pipe		197 39			
8/27/68	* 2Hrs. Labor taken off	27 76				

DATE _____

TOWN OF LEXINGTON — BOARD OF PUBLIC WORKS

SEWER DIVISION

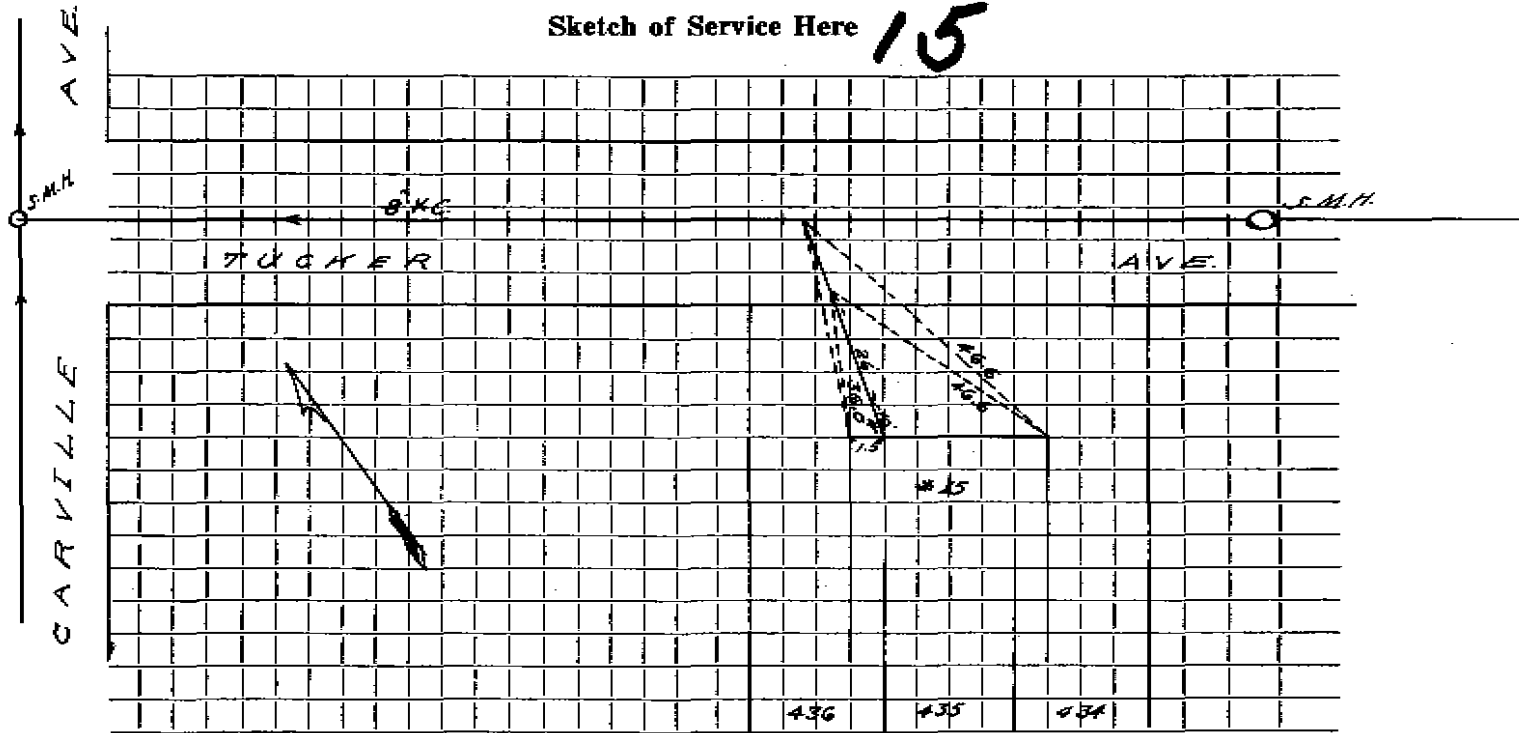

Connection made in Street. Work completed

Remarks:

.....

.....