

Address 16 Tucker Avenue, Lexington

16 Tucker Avenue

Location 16 Tucker Avenue

Kind of Pipe

Size 6"

Size of Main 8"

Installation - New Service

Location

Date		Material	Amount	Total	Date	Amount
Feb. 25,	'44	Labor	23 70		Let 10.1944 Deposited	60 00
26		"	22 00		Man report Paid	14 57
28		"	2 35	48 05		74 57
		10% Overhead		4 81		
		Compressor - 5 hrs. @ 2.25		11 25		
		Trucking- 3 hrs. @ .75		2 25		
		6' 4" Soil pipe @ 50¢		2 50		
		22' 6" V.C. Pipe @ 16¢		3 52		
		1 1/2" Bend		67		
		Jointing compound		1 50		
				74 55		
		Labor				

Con 2/24/44

Bill sent 3-21-44

Haley Bros. Inc., Lexington

TOWN OF LEXINGTON—BOARD OF PUBLIC WORKS  
SEWER DIVISION

DATE \_\_\_\_\_

NO. \_\_\_\_\_


The undersigned applies for the construction of a particular sewer connecting No. \_\_\_\_\_  
Street and hereby agrees to comply with the Rules and Regulations governing the construction and use of Particular  
Sewers, as now or at any future time established by the Board of Selectmen.

Am't. of Estimate \$ \_\_\_\_\_

Am't. Paid \$ \_\_\_\_\_

Owner \_\_\_\_\_

Sketch of Service Here

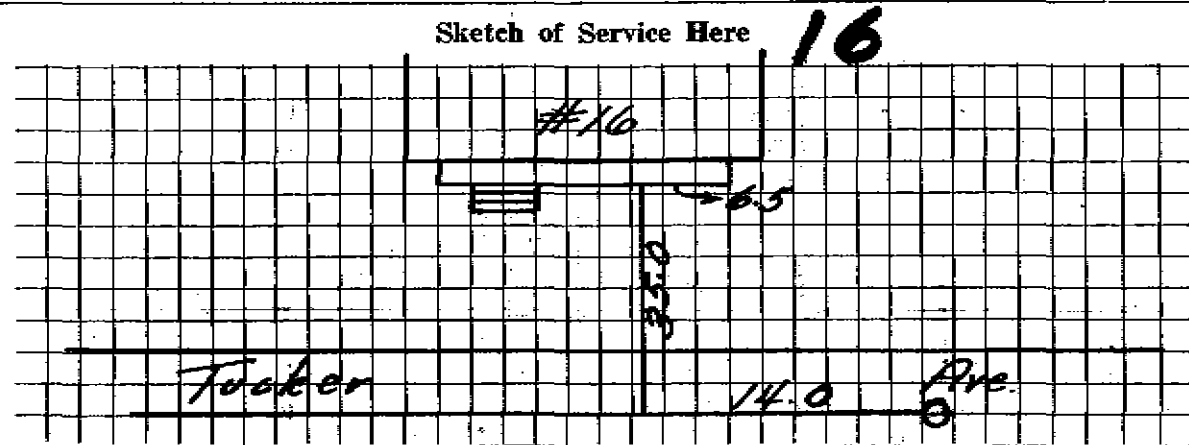

Connection made in \_\_\_\_\_ Street.

Work completed \_\_\_\_\_ 19

Remarks: