

Ervin H. Dix c/o Bristol & Lumber Co.,

Service No. 5777

Address 18 Tucker Avenue, Lexington, Mass.

18 Tucker Avenue

Location

Kind of Pipe

Size 6"

Size of Main 8"

~~Renewal~~—New Service

Location

Date 1943	Material	Amount	Total	Date	Amount
5/14/43	45½ hrs. @ 65¢	29 58		May 5, 1943 Deposited	100 00
<i>Comp. 11/17/43</i>	25 " @ 70¢	17 50			
	23 " @ 80¢	18 40	65 48.		
	10% Overhead		6 55.		
	24' 6" Sewer Pipe @ 16¢		3 84.		
	2 6" 1/8 Bends @ 67¢		1 34.		
	Joint compound		1 44.		
	3½ Bags Cement @ 70¢		2 45.		
	1 hr. compressor		2 25.		
	2 hrs. trucking @ 75¢		1 50.		
	Trench repairs		15 27.		
			100 12		
	Labor Say: \$100.00				

Hedley Pipe Co., Inc., Lexington

TOWN OF LEXINGTON—BOARD OF PUBLIC WORKS
SEWER DIVISION

DATE

5/5/43

NO.

The undersigned applies for the construction of a particular sewer connecting No. 18 Tucker Ave
Street and hereby agrees to comply with the Rules and Regulations governing the construction and use of Particular
Sewers, as now or at any future time established by the Board of Selectmen.

Am't. of Estimate \$

100⁰⁰


Am't. Paid \$

Erwin R. Dief

Owner

Sketch of Service Here

18

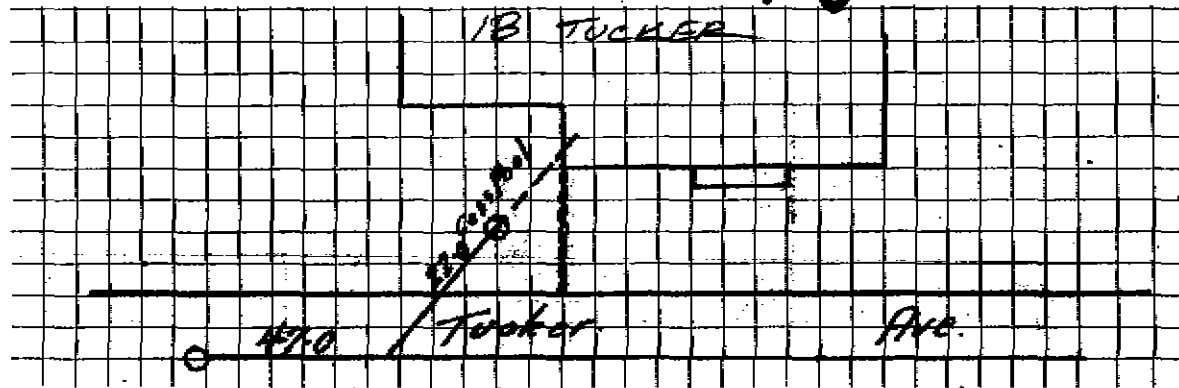

Connection made in _____

Street.

Work completed _____

19

Remarks: