

Name Ace Construction Trust

Service No. 71

Address 21 Tucker Avenue

21 Tucker Avenue

Location

Kind of Pipe Valeri Cont. #A323

Size 6"

Size of Main 8"

~~Replaced~~ New Service W.O. #2447

Location OCT 3 1966

Date	Material	Amount	Total	Date	Amount
'15/66	Labor	56.81		6-3-66	100.00
'30/66	"	22.30	79.11	12-6-66	48.62
	10% O.H.	7.91	87.02		148.62
20'	6" Transite pipe @.88		17.60		
4 1/2	hrs. Trucking @3.00		13.50		
13	hrs. Backhoe @6.50		19.50		
1	ton Hot top		5.50		
1	hr. Roller @3.00		3.00		
1/2	hr. Compressor @5.00		2.50		
			148.62		
18/66	33' 6" Transite pipe				
	10' Cast Iron				


Deposit Paid

Balance 48.62

DATE _____

TOWN OF LEXINGTON — BOARD OF PUBLIC WORKS
SEWER DIVISION

Sketch of Service Here **21**

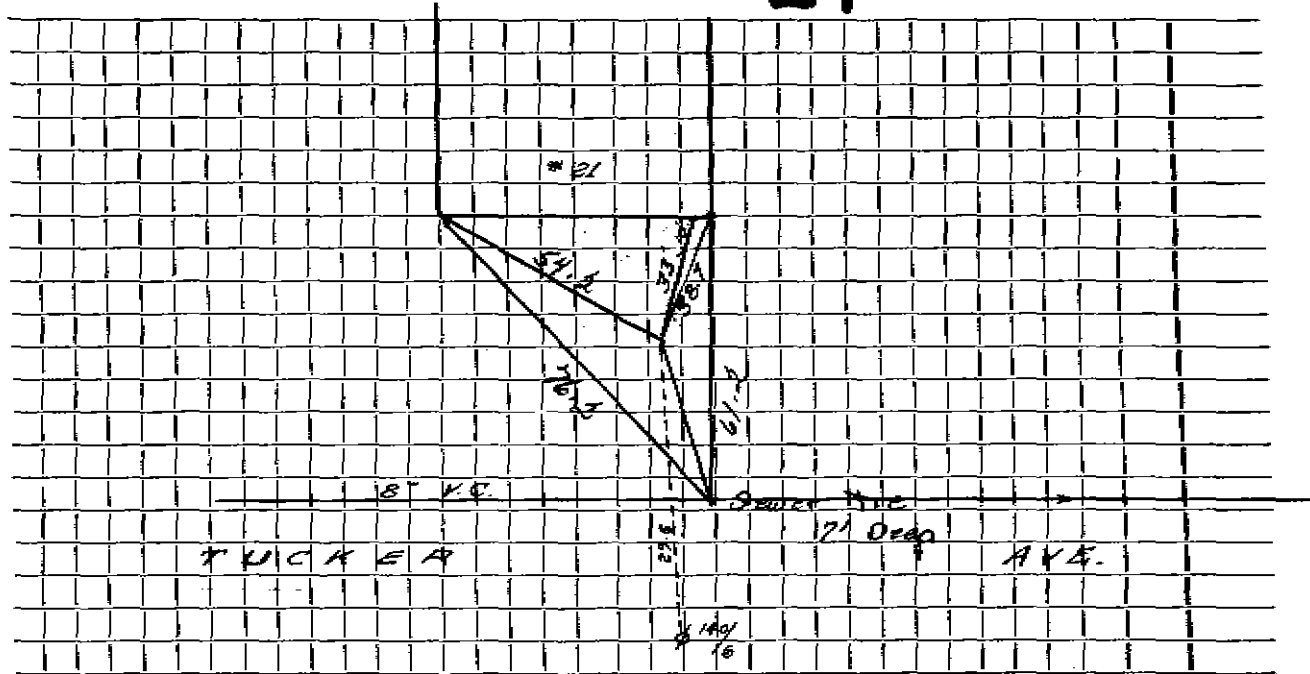

Connection made in Street. Work completed

Remarks:
.....
.....