

Name **Herbert Evans (Watertown Co-operative)**

Service No. **15 1506**

Address **22 Tucker Avenue**

Lexington 73, Mass.

Location **22 Tucker Avenue**

Kind of Pipe

Size **6"**

Size of Main **8"**

Repair—Renewal—New Service

Location

Date	Material	Amount	Total	Date	Amount
9-21-45	Labor	46 05		Sept 16 45	120 00
9-22-45	"	16 00	62 05	Oct 4 45	23 06
	10% Overhead		6 21		96 94
	62' - 6" Sewer Pipe @.22		13 64		
	Joint Compound		3 72		
	Compressor 1 hr. @1.75		1 75		
	Trucking 3 hrs. @.75		2 25		
	Patching 11 x 3		7 32		
			96 94		
	Labor				

TOWN OF LEXINGTON—DEPT. OF PUBLIC WORKS

SEWER DIVISION

DATE

NO.


The undersigned applies for the construction of a particular sewer connecting No. Street and hereby agrees to comply with the Rules and Regulations governing the construction and use of Particular Sewers, as now or at any future time established by the Board of Selectmen.

Am't of estimate \$.....

Am't Paid \$.....

..... Owner

Sketch of Service Here **22**

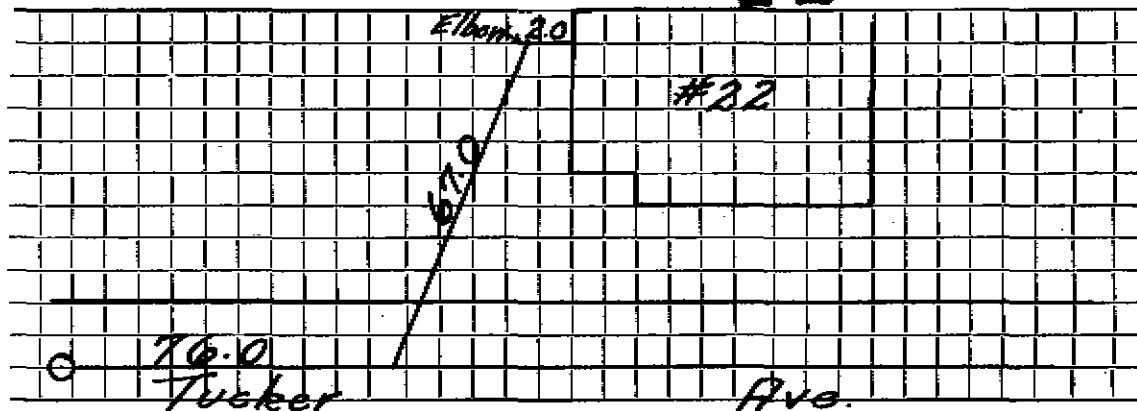

Connection made in Street.

Work completed 19..

Remarks: