

Name Ace Construction Trust

Service No. 72

Address 23 Tucker Avenue

23 TUCKER AVENUE

Location

Kind of Pipe

Size 6"

Size of Main 8"

~~Revised~~ New Service Valeri #A 322 W.O. #2448

Location OCT 3 1966


Date	Material	Amount	Total	Date	Amount
5/14/66	Labor	54.56		6-3-66	100 00
5/30/66	"	22.30	76.86	12-6-66	47 77
	10% O.H.	7.69	84.55		147 77
	20' 6" Transite pipe @.88		17.60		
	1 1/4 ton Patch @5.50		6.87		
	3 1/2 hrs. Town Shovel @6.50		22.75		
	3 1/2 hrs. Trucking @3.00		10.50		
	1/2 hr. Town Compressor @5.00		2.50		
	1 hr. Town Roller @3.00		3.00		
			147.77		
1/17/66	30' 6" Transite pipe				
				4 1/2 ft	Broken pipe
					Bill sent 47 77

DATE \_\_\_\_\_

TOWN OF LEXINGTON — BOARD OF PUBLIC WORKS

SEWER DIVISION

Sketch of Service Here **23**

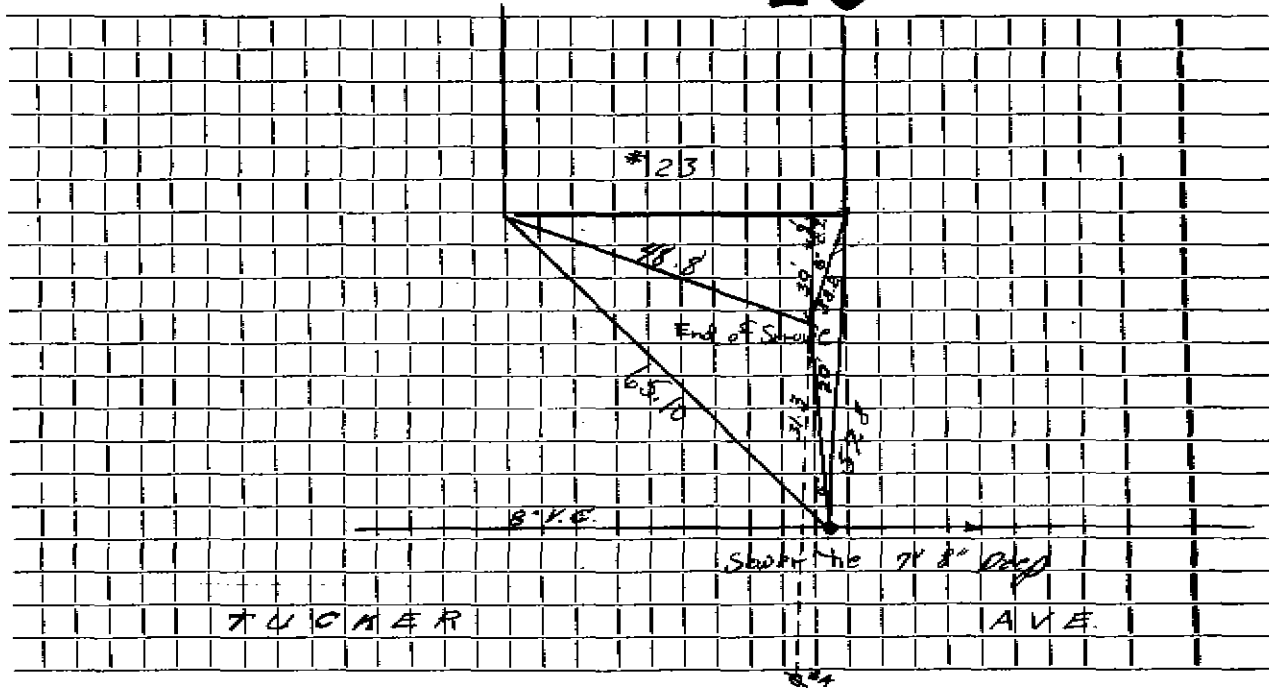

Connection made in ..... Street. Work completed .....

Remarks: .....

.....

.....