

Name Ace Construction Trust  
 Address 25 Tucker Avenue  
16 Bartlett Ave. Lexington, Mass.

Service No. 73

25 TUCKER AVENUE  
 Valeri Construction Co. Permit #321

Location

Kind of Pipe \_\_\_\_\_ Size 6" Size of Main 8"

~~REPLACEMENT~~ **New Service** W.O. #2449 Valeri Const #321

Location JUL 25 1966

Date	Material	Amount	Total	Date	Amount
10-66	Labor	90.16		5-26-66	100.00
30-66	"	12.88		7-25-66	7.00
30-66	"	6.64	109.68	<del>8-2-66</del>	<del>4.00</del>
	10% O.H.	10.97	120.65	8-16-66	103.93
22'	6" Transite pipe @.82		18.04		207.94
1 1/2	Ton Hot Top @5.50		8.25		
4	Hrs. Trucking @3.00		12.00		
6	Hr. Town Shovel @6.50		39.00		
1	Hr. Compressor		5.00		
1	Hr. Roller		3.00		
1	Hr. Trailer		2.00		
			207.94		
11-66	27' 6" Transite				

Deposit  
 Paid by W.H.C. #321  
~~Paid out~~  
 Paid

Bill sent 103.93


DATE \_\_\_\_\_

TOWN OF LEXINGTON — BOARD OF PUBLIC WORKS

SEWER DIVISION

Sketch of Service Here

25

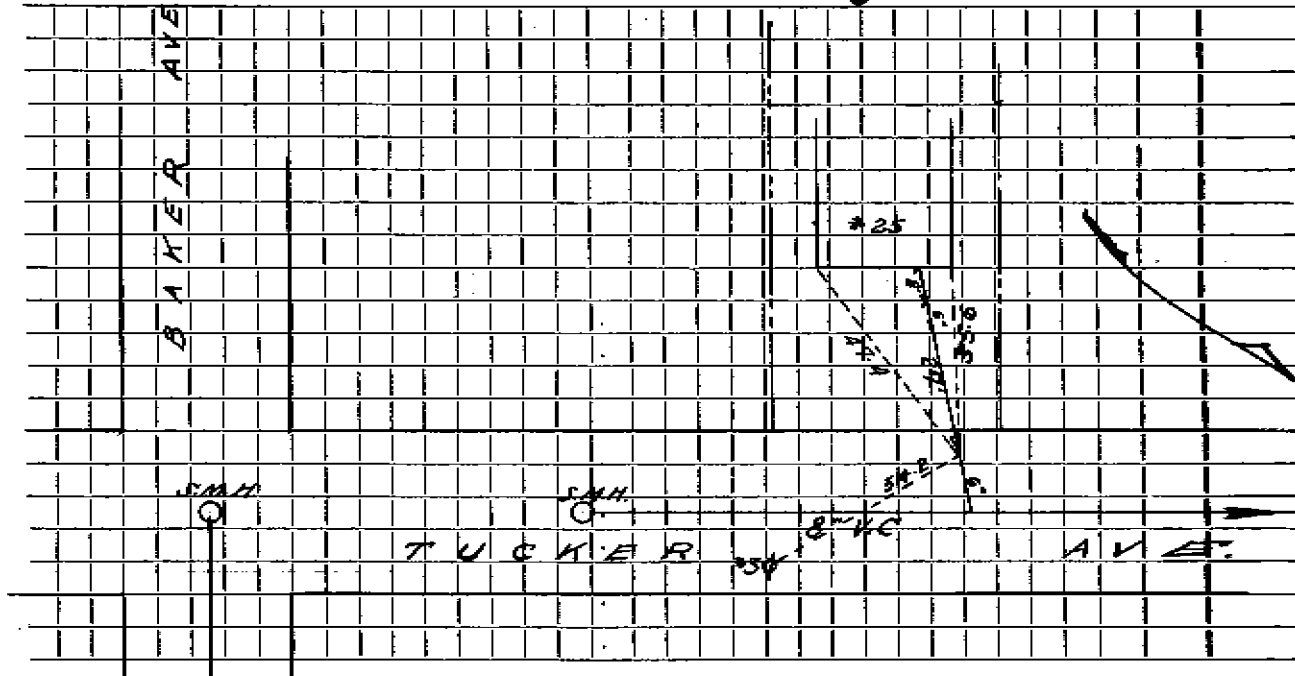

Connection made in ..... Street. Work completed .....

Remarks: .....

.....  
.....