

Name

Service No.

Address 5 Tucker Avenue

5 Tucker Avenue

Location

Kind of Pipe

Size 6"

Size of Main 8"

Repair ~~Renewal~~ ~~New Service~~ W.O. #1991

Location


Date	Material	Amount	Total	Date	Amount
11-12-52	99' 6" Sewer Pipe				
	1 6" Elbow				
					REPAIR
				9/20/83	15' 6" P.V.C.
				2	6" Clay to P.V.C. Fernco
				10	yds. Gravel
				2	Ton Cold Patch
					Patch 22' x 15'
				2-15-82	59' OUT
				12-6-77	ROOTS @ Main line 60' OUT

DATE _____

TOWN OF LEXINGTON — BOARD OF PUBLIC WORKS

SEWER DIVISION

Sketch of Service Here **5**

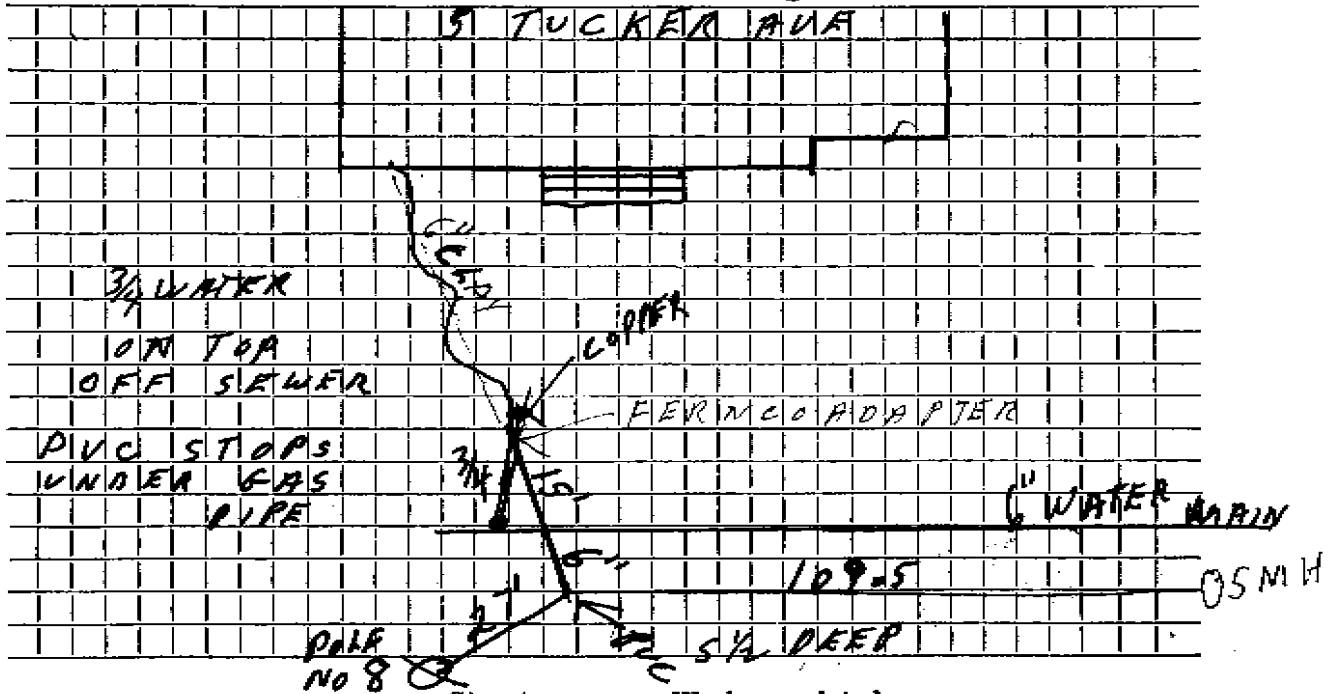

Connection made in Street. Work completed

Remarks:

.....

.....