


DATE _____

TOWN OF LEXINGTON — BOARD OF PUBLIC WORKS
SEWER DIVISION

Sketch of Service Here

8

LOT #

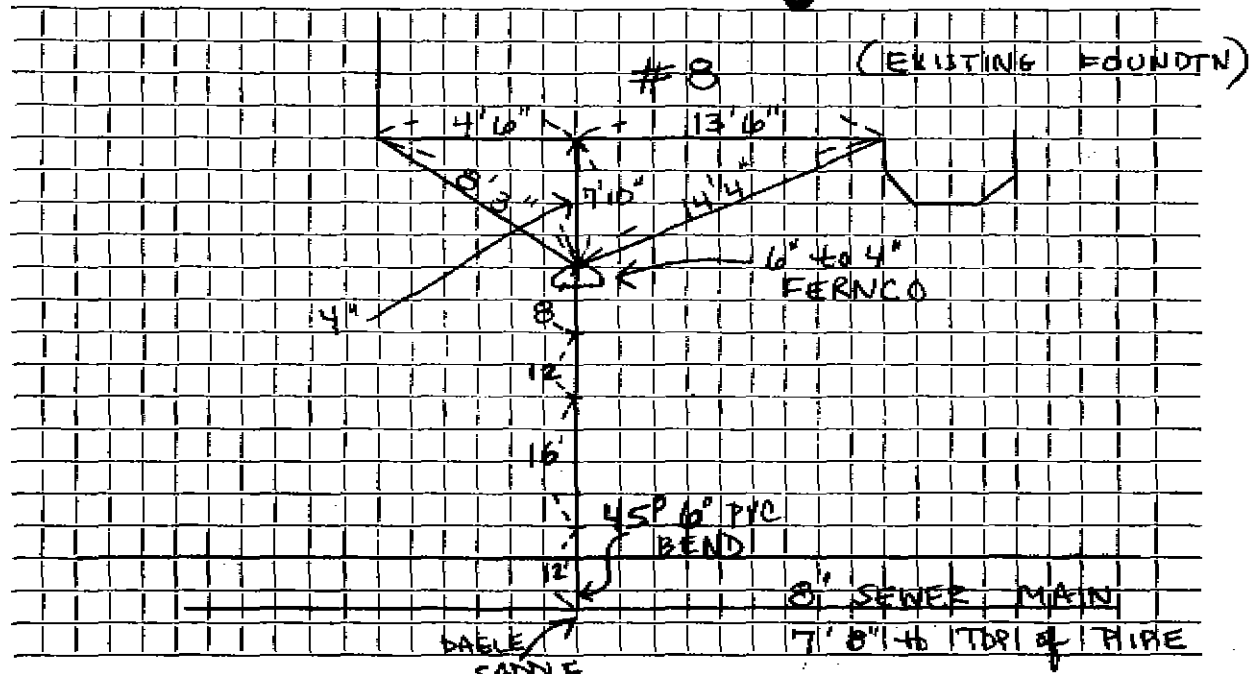

Connection made in TUCKER AVE. Street. Work completed

Remarks: