

Name Allen E. Heighton

Service No. #88

Address 9 Tucker Avenue

36-137-1-30

9 Tucker Avenue

Location

Kind of Pipe

Size 6"

Size of Main 8"

Repair—Renewal—New Service WO #7371 Lucente #1263

Location Comm 10-1-62

Date	Material	Amount	Total	Date	Amount
6-26-62	Labor	71.51		6-20-62	250.00
	10% O.H.	7.15	78.66	10-1-62	53.88
72	6" Transite Pipe @.78		56.16		196.12
1	90° 6" Transite Elbow		4.09		
1	Duplex Adapter		1.62		
1	1 1/2° Transite Bend		4.09		
5	Hrs. Town Shovel @5.50		27.50		
2	Hrs. Trucking @3.00		6.00		
	18X3 Patch		18.00		
			196.12		
1-29-68	45' 6" Transite pipe				
	10' 4" Cast Iron pipe				


DATE \_\_\_\_\_

# TOWN OF LEXINGTON — BOARD OF PUBLIC WORKS

## SEWER DIVISION

Sketch of Service Here

9

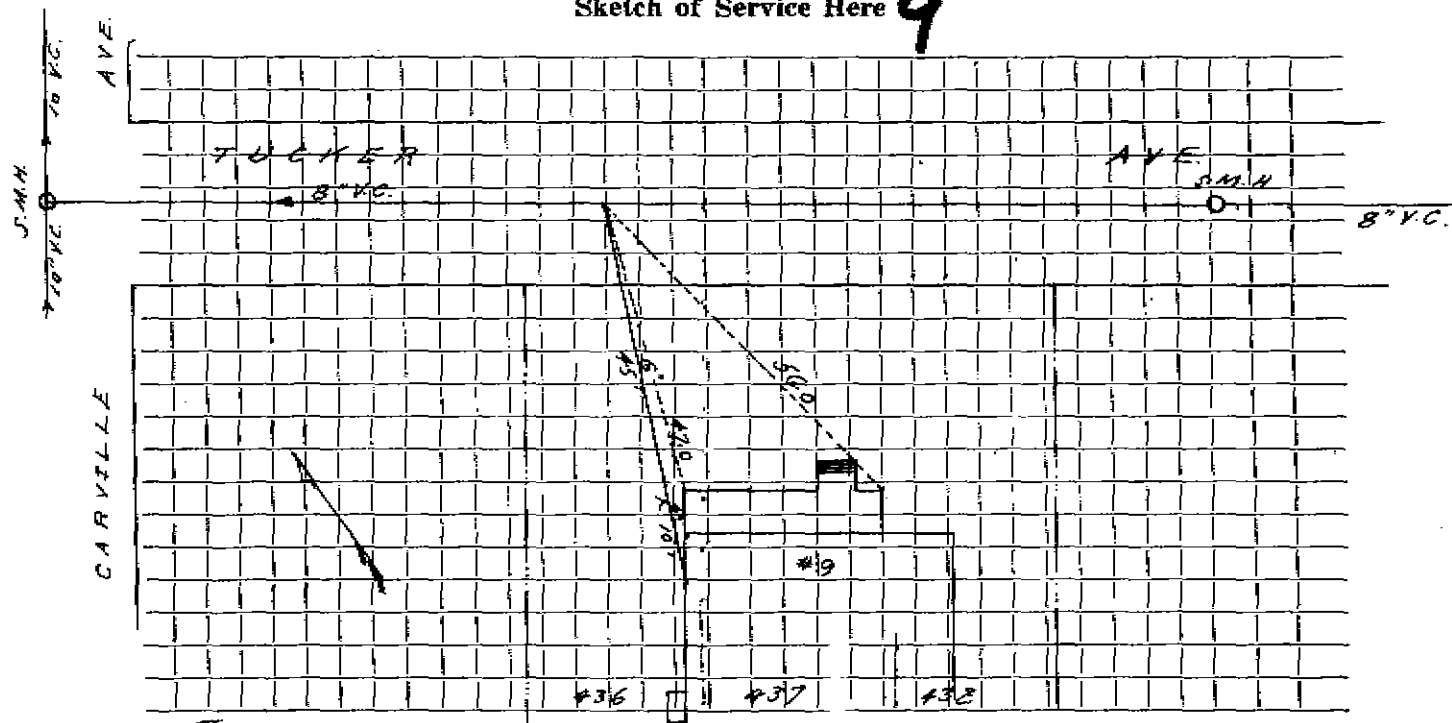

Connection made in TUCKER AVE Street. Work completed .....

Remarks: .....

.....

.....