

Name Cary Realty

Service No. 125

Address # 11 TUFTS RD.

11 Tufts Road

Location LOT # 349

Kind of Pipe

Size 6"

Size of Main 8"

~~XXXXXXXXXX~~ New Service

Location Conn 11-9-59

Date	Material	Amount	Total	Date	Amount
8-12-59	Labor	52.83		8-28-59	Deposit 100.00
	10% O.H.	5.28	58.11	12-1-59	Paid 18.79
51'	6" Transite pipe @.70		35.70		118.79
1	11 1/4" Transite Elbow		2.24		
1	22 1/2" Transite Elbow		2.24		
2	hrs. Town Shovel @6.50		13.00		
1	hr. Trucking @3.00		3.00		
1	hr. Rogers Trailer @3.00		3.00		
2	hrs. Trucking @.75		1.50		
			118.79		
	Labor				
				Bill sent 11-9-59	18.79

# TOWN OF LEXINGTON—DEPT. OF PUBLIC WORKS

## SEWER DIVISION

DATE .....

NO. ....


The undersigned applies for the construction of a particular sewer connecting No. .... Street and hereby agrees to comply with the Rules and Regulations governing the construction and use of Particular Sewers, as now or at any future time established by the Board of Selectmen.

Am't of estimate \$.....

Am't Paid \$.....

..... Owner

Sketch of Service Here //

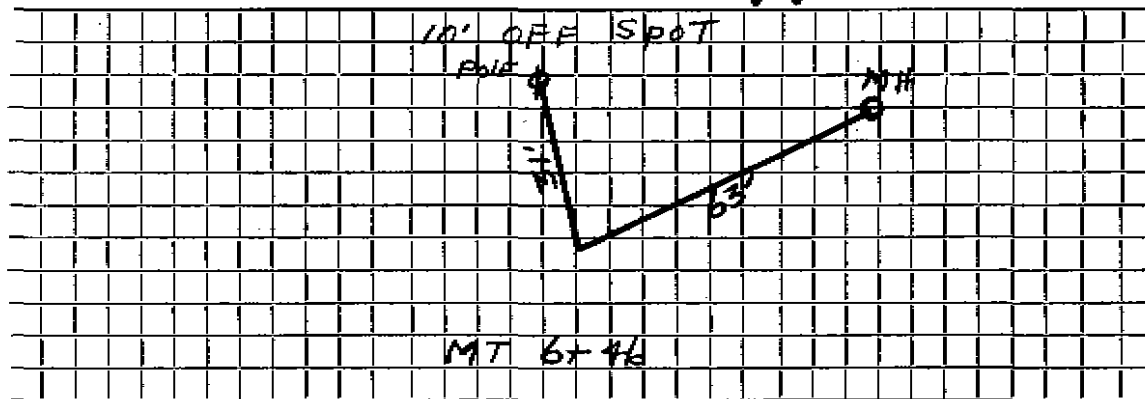

Connection made in ..... Street.

Work completed ..... 19..

Remarks: