

Name George Krikorian

Service No. 186

Address # 12 TUFTS RD.

Comm. 2/16/59

12 Tufts Road

Location LOT # 323

Kind of Pipe

Size 6"

Size of Main 8"

Repair—Renewal—New Service

Location

Date	Material	Amount	Total	Date	Amount
11/18/58	Labor	27 24		10/29/58	Deposit \$ 100 00
	10% overhead	2 72	29 96	2/16/59	Refund \$ 24 59
	40' - 6" Transite pipe @ .70		28 00		\$ 75 41
	2 - 11 $\frac{1}{2}$ " Transite bends @ 5.10		10 20		
	1 hr. Town Shovel		6 50		
	1 hr. Trucking		75		
			75 41		
					* \$2.00 applied to W.H.C. #232
				3/27/68	Herbage disposed
				7/17/68	Billy as paper on broken joint
	Labor			12/16/68	Paper

TOWN OF LEXINGTON—DEPT. OF PUBLIC WORKS

SEWER DIVISION

DATE

NO.


The undersigned applies for the construction of a particular sewer connecting No. Street and hereby agrees to comply with the Rules and Regulations governing the construction and use of Particular Sewers, as now or at any future time established by the Board of Selectmen.

Am't of estimate \$.....

Am't Paid \$.....

..... Owner

Sketch of Service Here 12

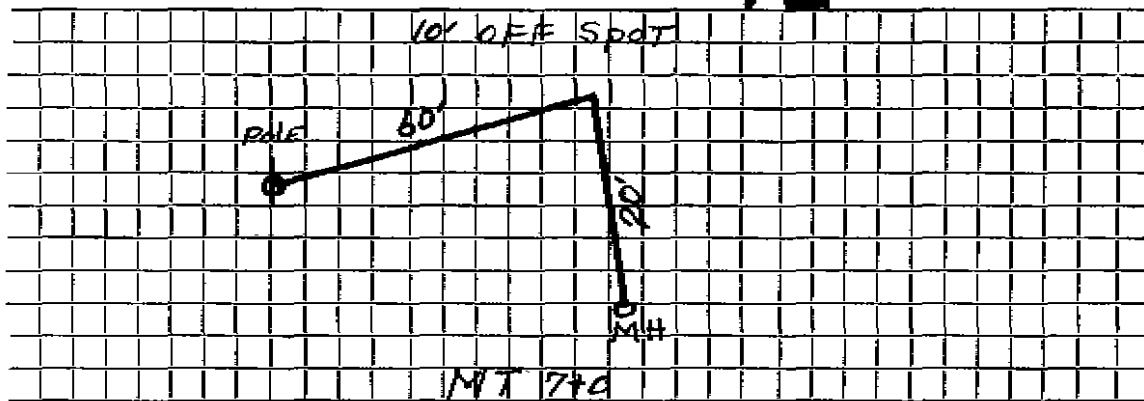

Connection made in Street.

Work completed 19..

Remarks: