

Name **Leonard Colwell**Service No. **80**Address # **15 TUFTS RD.****15 Tufts Road**Location **LOT# 350**

Kind of Pipe

Size **6"**Size of Main **8"**~~Repair/ Renewal~~ **New Service**Location **Comm 7-17-61**

Date	Material	Amount	Total	Date	Amount
6-27-61	Labor	36.88		6-23-61	Deposit 200.00
6-28-61	Labor	30.27	67.15	7-17-61	Refund 39.10
	10% O.H.	6.72	73.87		160.90
	54' 6" Transite pipe @.78		42.12		
	2 11 1/4° Transite Elbows @5.10		10.20		
	1 22 1/2° Transite Bend		6.21		
	3 Hrs. Town Shovel @6.50		19.50		
	3 Hrs. Trucking @3.00		9.00		
			160.90		
	Labor			1/3/77	Roots about 51' out
HP-6411					

TOWN OF LEXINGTON—DEPT. OF PUBLIC WORKS

SEWER DIVISION

DATE

NO.


The undersigned applies for the construction of a particular sewer connecting No. Street and hereby agrees to comply with the Rules and Regulations governing the construction and use of Particular Sewers, as now or at any future time established by the Board of Selectmen.

Am't of estimate \$.....

Am't Paid \$.....

..... Owner

Sketch of Service Here **15**

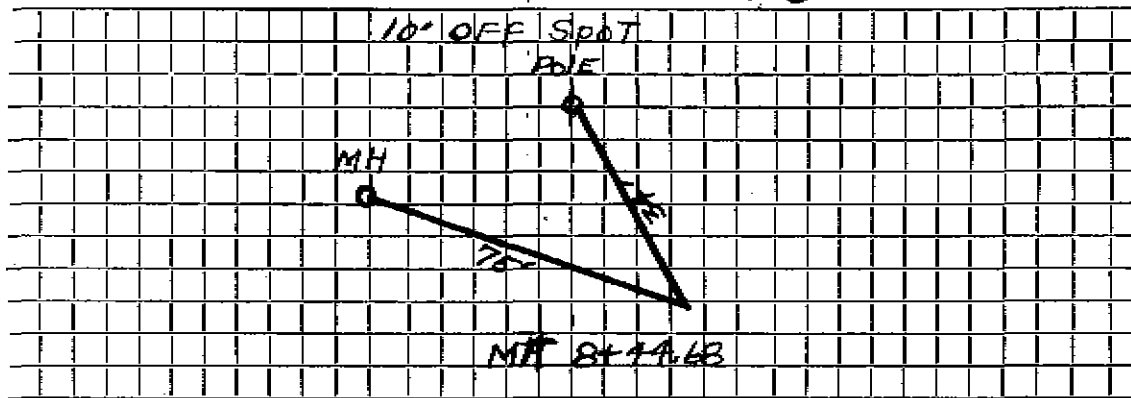

Connection made in Street.

Work completed 19..

Remarks: