

Name Peter Toumayan

Service No. 60

Address # 19 TUFTS RD.

19 Tufts Road

Location LOT 332

Kind of Pipe

Size 6"

Size of Main 8"

~~Repair/Service~~ - New Service

WO # 8677

Location Conn 9-23-64

Date	Material	Amount	Total	Date	Amount
6-4-64	Labor	68 12		4-23-64	200 00
	10% O.H.	6 81	74 93	9-21-64	80 79
	29' 6" Transite pipe @ .82		23 78		119 51
	1 Bag Cement		1 50		
	2 Hrs Town Shovel @ 6.50		13 00		
	2 Hrs Trucking @ 3.00		6 00		
			119 21		
	Labor				

TOWN OF LEXINGTON—DEPT. OF PUBLIC WORKS.

SEWER DIVISION

DATE

NO.


The undersigned applies for the construction of a particular sewer connecting No. Street and hereby agrees to comply with the Rules and Regulations governing the construction and use of Particular Sewers, as now or at any future time established by the Board of Selectmen.

Am't of estimate \$.....

Am't Paid \$.....

..... Owner

Sketch of Service Here 19

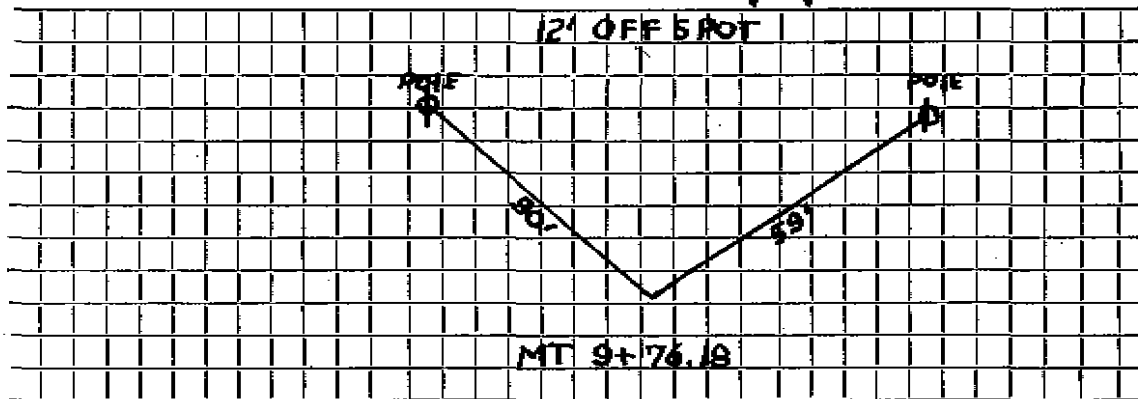

Connection made in Street.

Work completed 19..

Remarks: