

Name Oman-McCormick Const. Co.

Service No. 13

Address # 22 TUFTS RD.

Comm. 4/29/57

22 Tufts Road

Location LOT# 327

Kind of Pipe

Size 6"

Size of Main 8"

~~Repair~~ ~~Renewal~~ New Service

Location

Date		Material	Amount	Total	Date	Amount	
3-7-57		Labor	19.15		3-4-57	Deposit	\$ 100.00
		10% C.H.	1.95	21.07	4-29-57	Refund	40.23
		53' 6" Transite pipe @.7020		37.20			\$ 59.77
		2 hrs. Trucking @.75		1.50			
				59.77			
		Labor					

# TOWN OF LEXINGTON—DEPT. OF PUBLIC WORKS

## SEWER DIVISION

DATE .....

NO. ....


The undersigned applies for the construction of a particular sewer connecting No. .... Street and hereby agrees to comply with the Rules and Regulations governing the construction and use of Particular Sewers, as now or at any future time established by the Board of Selectmen.

Am't of estimate \$.....

Am't Paid \$.....

..... Owner

Sketch of Service Here **22**

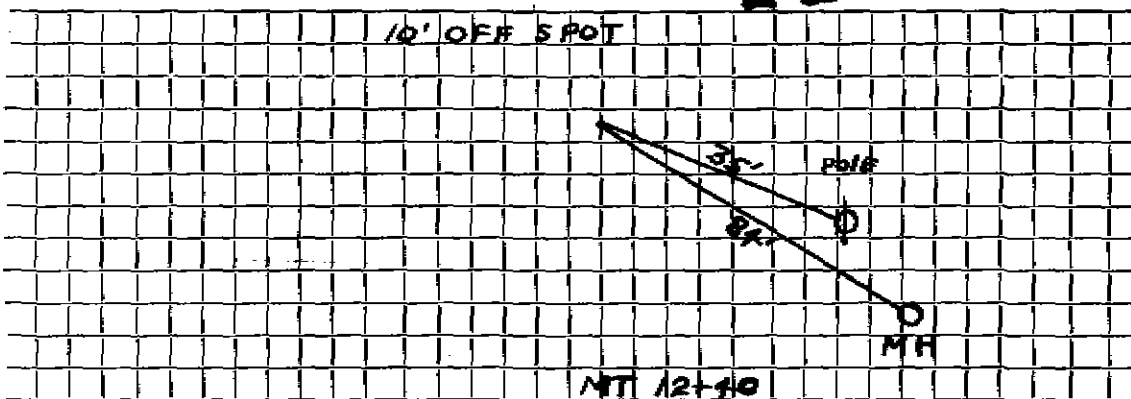

Connection made in ..... Street.

Work completed ..... 19..

Remarks: