

Name Joseph P. Spinelli

Service No. 94

Address #23 TUFTS RD.

23 Tufts Road

Location LOT # 330

Kind of Pipe

Size 6"

Size of Main 8"

~~New Service~~ New Service

Location *Comm 8-1-60*

Date	Material	Amount	Total	Date	Amount
6-13-60	Labor	16 63		<i>6-8-60</i>	<i>Deposit</i> 150 00
	10% O.H.	<u>1 66</u>	18 29	<i>8-1-60</i>	<i>Retard</i> 82 37
	50' 6" Transite pipe @78		39 00		<u>67 63</u>
	1 11 1/4° Transite Bend		5 16		
	1 22 1/2° Transite Elbow		2 24		
	1 Hr. Trucking @3.00		<u>3 00</u>		
			67 63		
	Labor				

TOWN OF LEXINGTON—DEPT. OF PUBLIC WORKS
SEWER DIVISION

DATE

NO.


The undersigned applies for the construction of a particular sewer connecting No.
 Street and hereby agrees to comply with the Rules and Regulations governing the construction and use of Particular
 Sewers, as now or at any future time established by the Board of Selectmen.

Am't of estimate \$.....

Am't Paid \$.....

..... Owner

Sketch of Service Here **23**

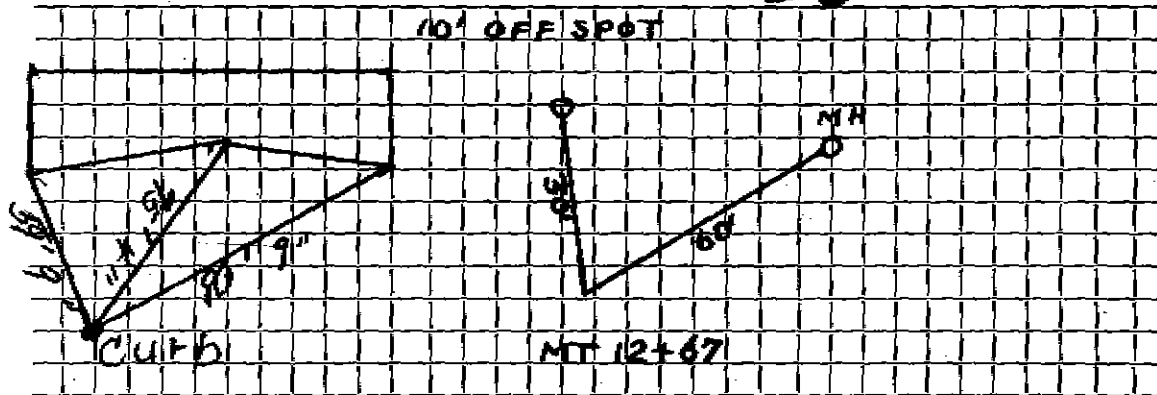

Connection made in Street. Work completed 19..

Remarks: