




TOWN OF LEXINGTON — BOARD OF PUBLIC WORKS

SEWER DIVISION

Sketch of Service Here

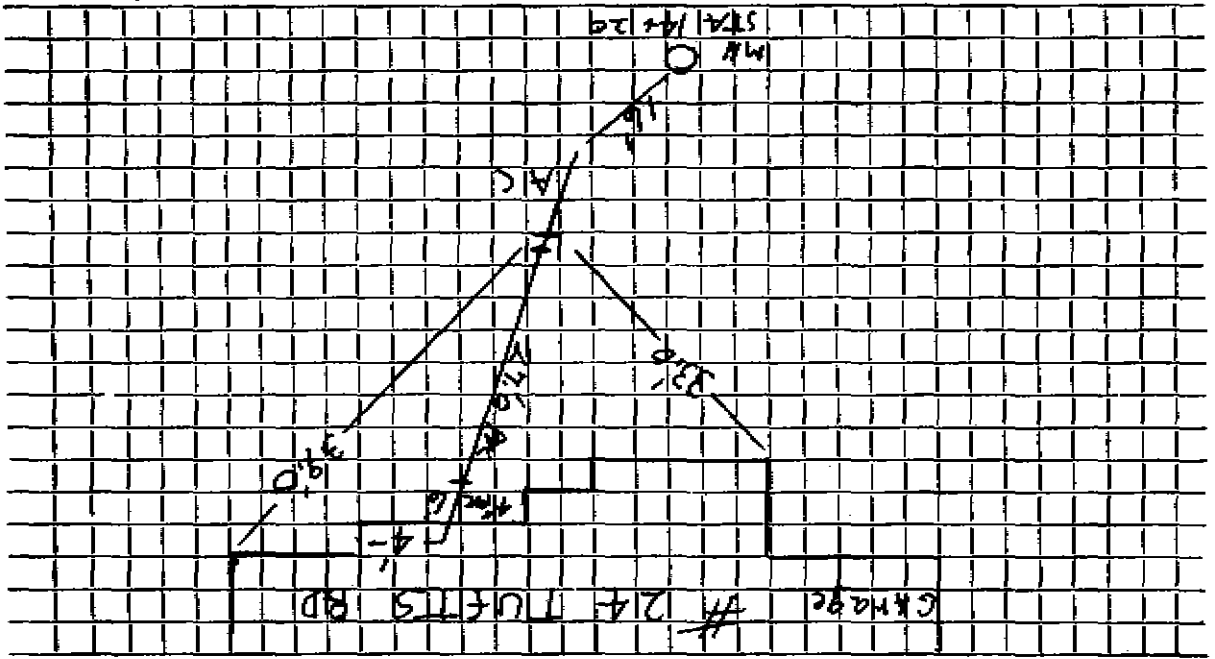

Connection made in  
Remarks:

Street.

Work completed

10/24/02 J.M.L.