

Name Joseph Spinelli

Service No. 95&114

Address # 25 TUFTS RD.

25 Tufts Road

Location LOT # 329

Kind of Pipe

Size 6"

Size of Main 8"

~~Work on Main~~ New Service

Location *Open 8-1-60*

Date	Material	Amount	Total	Date	Amount
7-6-60	Labor	66 82		6-8-60	Deposit 150 00
	10% O.H.	6 68	73 50	6-28-60	Deposit 100 00
96'	6" Transite pipe @78		74 88	8-1-60	* Retund 42 62
6	Hrs pippin shovel @6.50		39 00		207 38
2	Hrs Trucking @3.00		6 00		
	14 x 3 Patch		14 00		
			207 38		
	Labor				

* Apply 592 to WHP # 88

TOWN OF LEXINGTON—DEPT. OF PUBLIC WORKS
SEWER DIVISION

DATE

NO.


The undersigned applies for the construction of a particular sewer connecting No.
Street and hereby agrees to comply with the Rules and Regulations governing the construction and use of Particular
Sewers, as now or at any future time established by the Board of Selectmen.

Am't of estimate \$.....

Am't Paid \$.....

..... Owner

Sketch of Service Here **25**

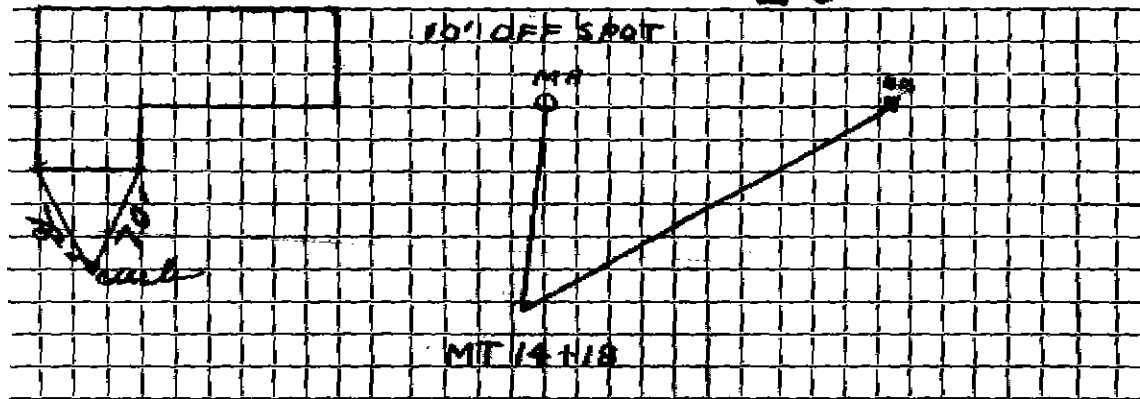

Connection made in Street. Work completed 19..

Remarks: