


TOWN OF LEXINGTON — BOARD OF PUBLIC WORKS

SEWER DIVISION

DATE _____

Sketch of Service Here

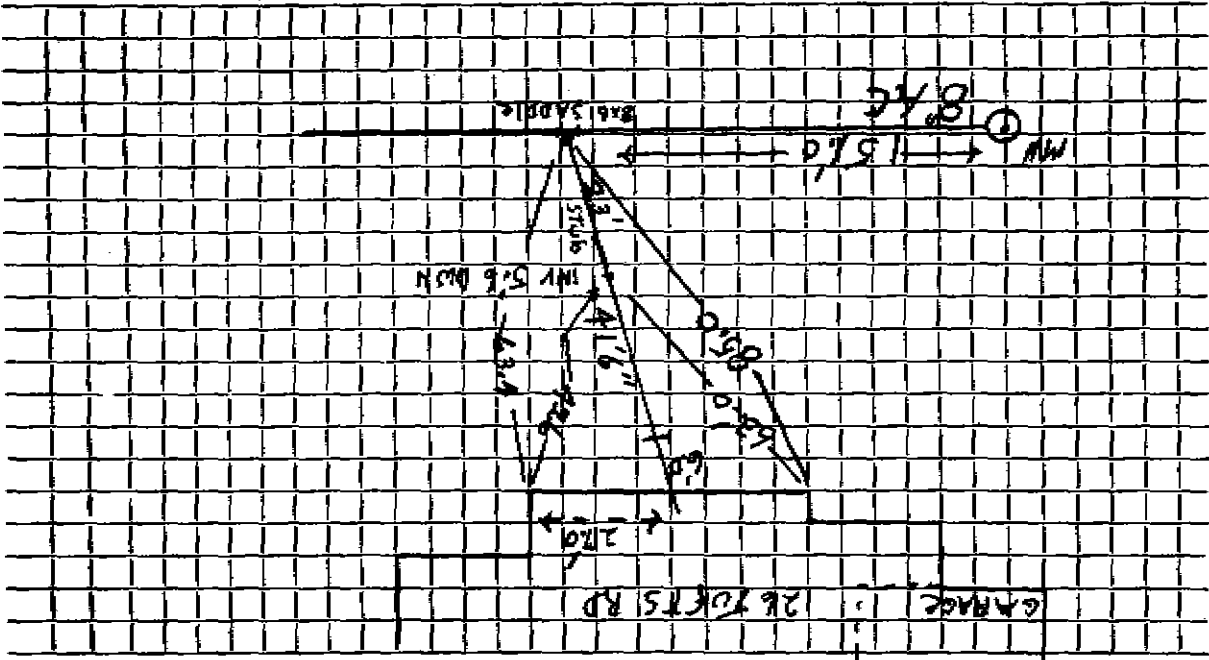

Connection made in _____

Street _____

Work completed _____

4/13/06 J. W. Langan, Jr.

Remarks: _____