

Name **Advanced Builders Realty Trust**

Service No. 193

Address #6 Tufts Rd.

6 Tufts Road

Location **LOT# 320**

Kind of Pipe

Size **6"**

Size of Main **8"**

~~Repair~~ ~~Renewal~~ **New Service**

Location *Cam 11-21-62*

Date	Material	Amount	Total	Date	Amount
10-4-60	Labor	26 08		9-27-61	150 00
	10% O.H.	2 61	28 69	11-21-62	24 85
	37' 6" Transite pipe @78		28 86		75 15
	1 11 1/4" Transite Bend		5 10		
	1 Hr. Town Shovel @6.50		6 50		
	1 Hr. Trucking @3.00		3 00		
	1 Hr. Loader @3.00		3 00		
			75 15		
	Labor				

TOWN OF LEXINGTON—DEPT. OF PUBLIC WORKS

SEWER DIVISION

DATE

NO.


The undersigned applies for the construction of a particular sewer connecting No. Street and hereby agrees to comply with the Rules and Regulations governing the construction and use of Particular Sewers, as now or at any future time established by the Board of Selectmen.

Am't of estimate \$.....

Am't Paid \$.....

..... Owner

Sketch of Service Here **6**

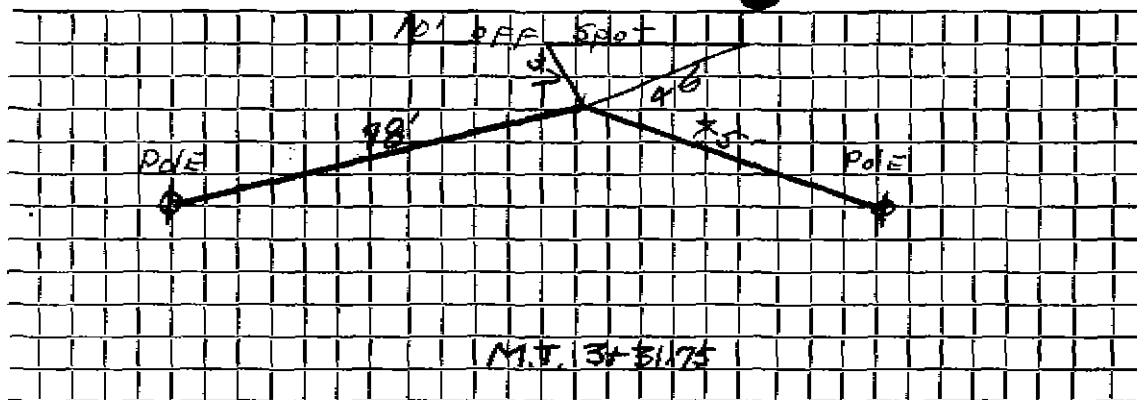

Connection made in Street.

Work completed 19..

Remarks: *Is connected to sewer.*