




DATE \_\_\_\_\_

TOWN OF LEXINGTON — BOARD OF PUBLIC WORKS  
SEWER DIVISION

Sketch of Service Here **7**

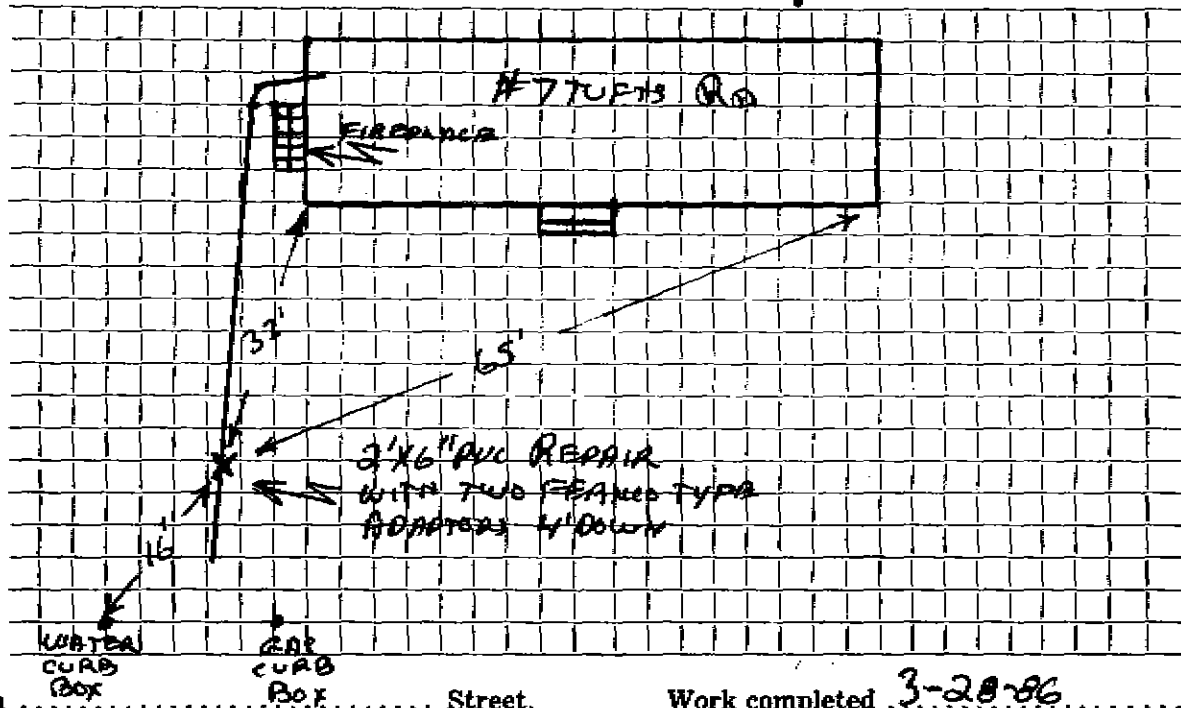

Connection made in ..... Street. Work completed **3-28-86**.....

Remarks: **GAS 2' DEEP - SEWER 4' DEEP - WATER UNDER SEWER, ALL IN SAME TRENCH.....**

**Original Service 2-27-61 (48" 6" Transite).....**