




DATE \_\_\_\_\_

**TOWN OF LEXINGTON — BOARD OF PUBLIC WORKS**  
**SEWER DIVISION**

Sketch of Service Here

4

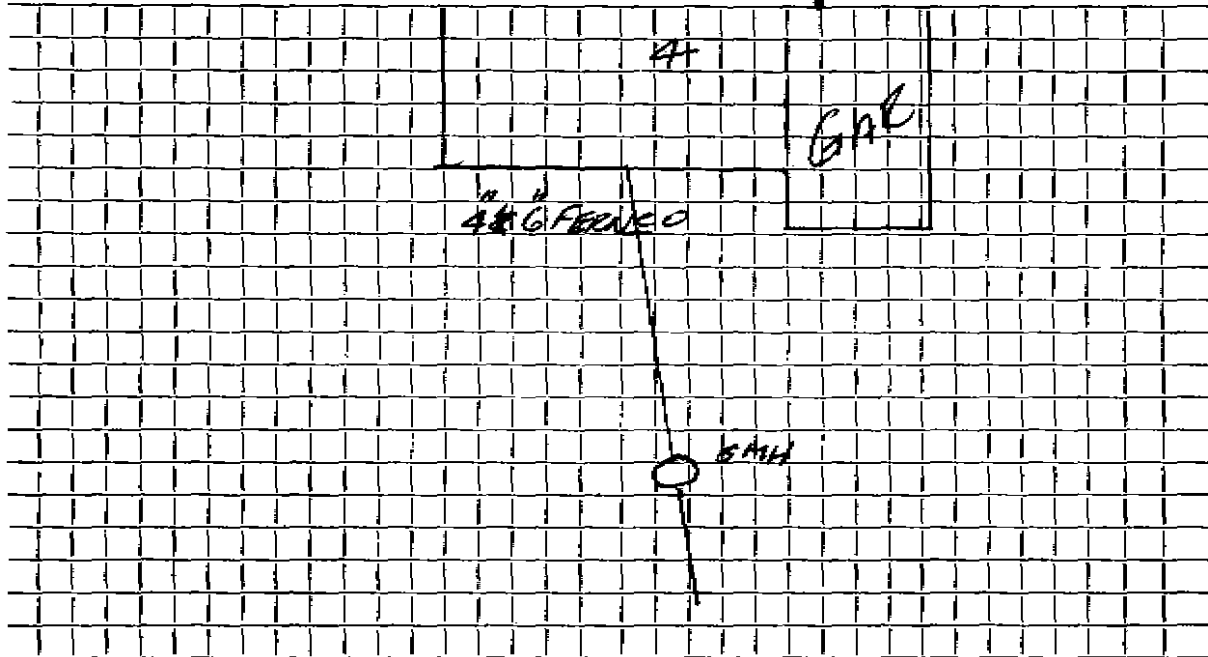

Connection made in TURNBERRY..... Street. Work completed .....

Remarks: .....  
.....  
.....