

Name Otis Brown

Service No.

Address 5 TURNBERRY HILL RD.

5 Turnberry Hill Road

Location

Kind of Pipe

Size 6"

Size of Main 8"

Repair—Renewal—New Service McLaughlin #0049


Location

Date	Material	Amount	Total	Date	Amount
6/7/89	4 F 6" PVC				
	4 F 4" PVC				
	8" X 6" WYE				
	4" X 6" FERRO				

DATE _____

TOWN OF LEXINGTON — BOARD OF PUBLIC WORKS
SEWER DIVISION

Sketch of Service Here **5**

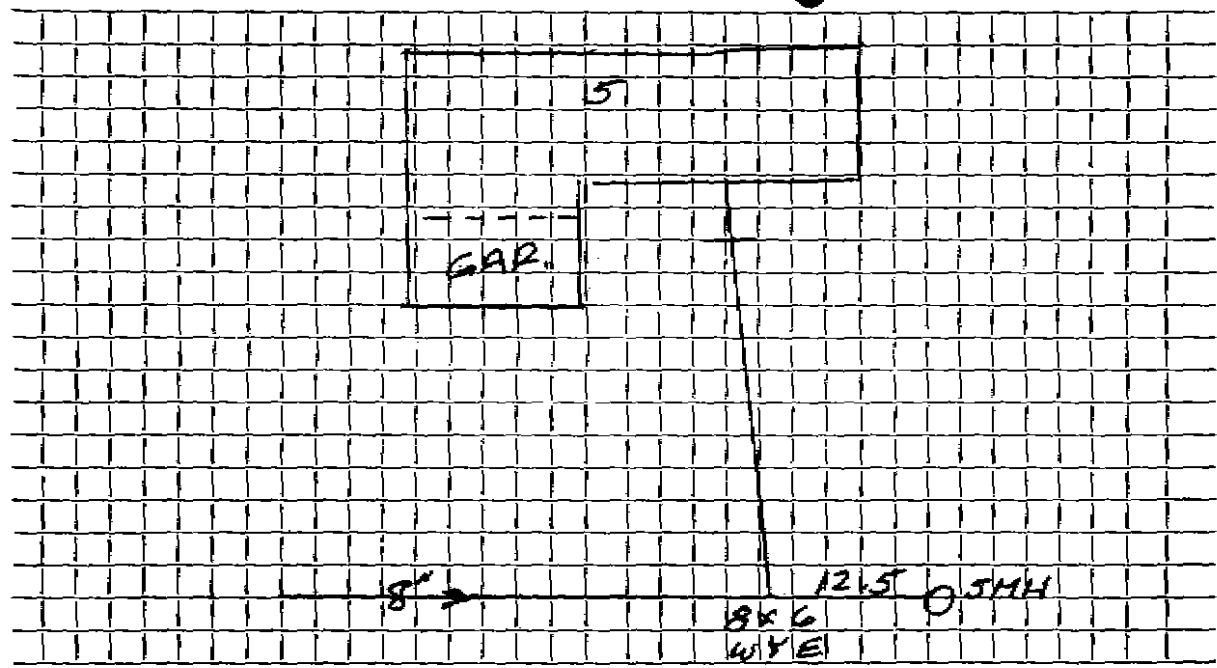

Connection made in TURNBERRY Street. Work completed

Remarks:
.....
.....