


DATE _____

TOWN OF LEXINGTON — BOARD OF PUBLIC WORKS
SEWER DIVISION

Sketch of Service Here **6+7**

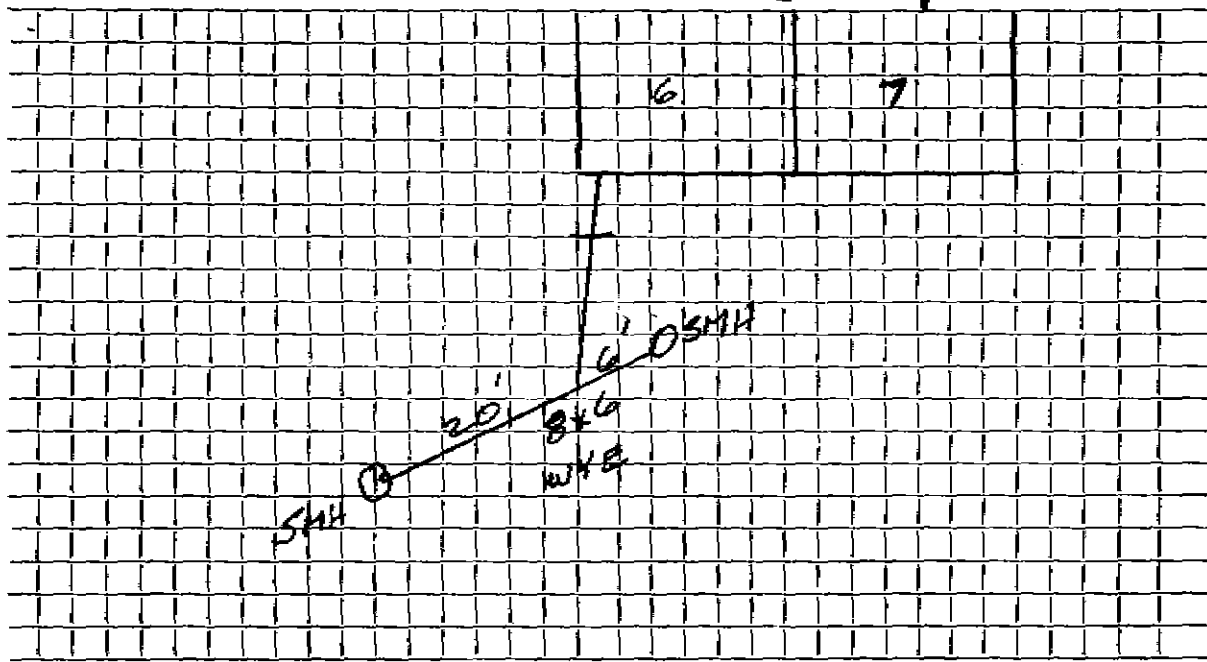

Connection made in TURNBERRY Street. Work completed

Remarks: