


DATE 5/14/2017

TOWN OF LEXINGTON — BOARD OF PUBLIC WORKS
SEWER DIVISION

Sketch of Service Here

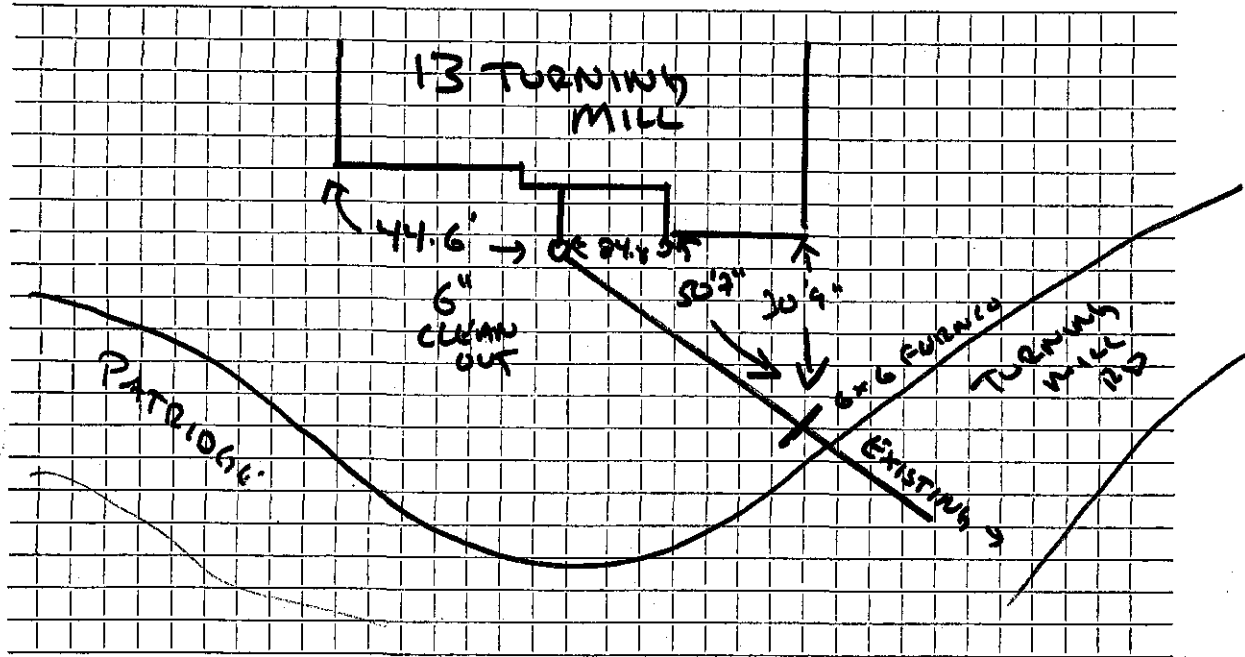

Connection made in ... TURNING MILL Street.

Work completed ... J. WHITE CONSTRUCTION

Remarks:

.....

.....