

Name Hajime Honda

Service No. 30

Address 14 Turning Mill Road

Lot #38 14 Turning Mill Road Location

Kind of Pipe

Size 6"

Size of Main 8"

Repair—Renewal—New Service Valeri #1350


Location MAY 27 1969

Date		Material	Amount	Total	Date		Amount	
1969	31	6" Transite pipe @10.00		310.00	5-9-69	Dyers P	310.00	00
5-15-69	12	6" Transite pipe						
	10	4" Cast Iron pipe						

TOWN OF LEXINGTON — BOARD OF PUBLIC WORKS

SEWER DIVISION

Sketch of Service Here **14**

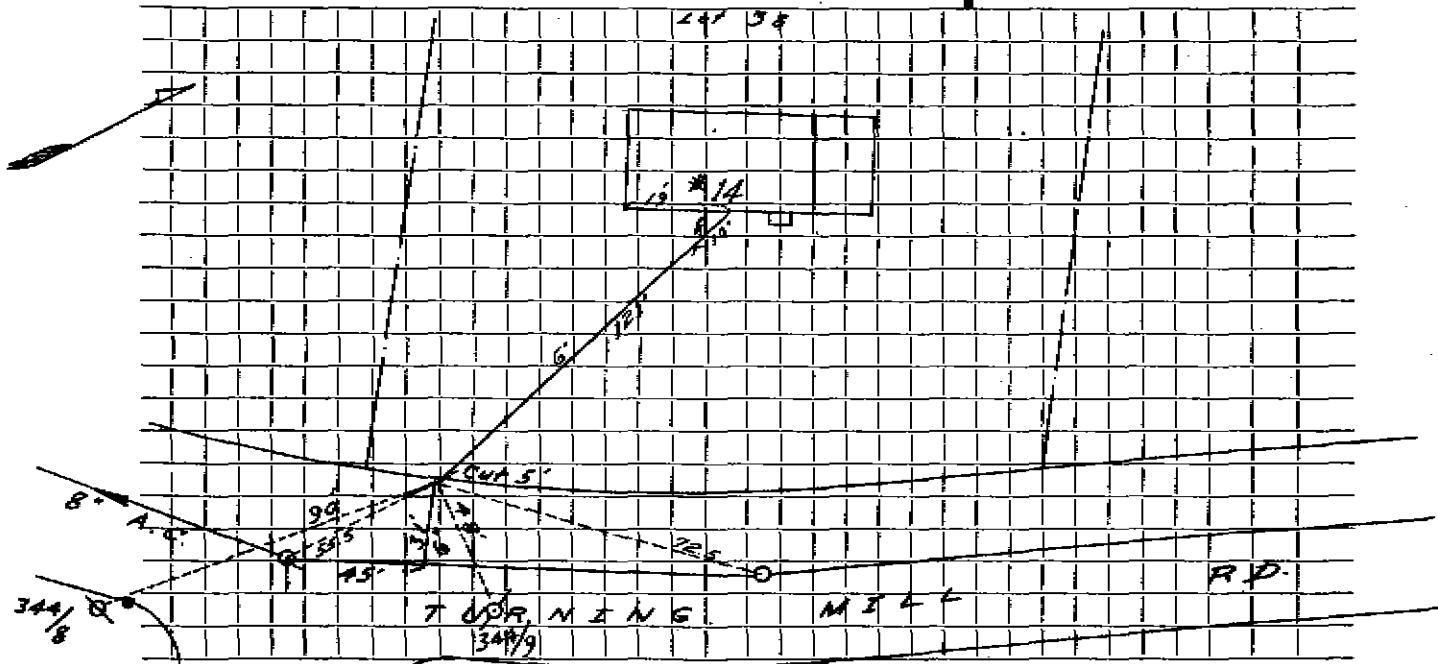

Connection made in \_\_\_\_\_ Street. Work completed \_\_\_\_\_

Remarks: \_\_\_\_\_

\_\_\_\_\_

\_\_\_\_\_