

Name Hoyt S. Grant, Jr.

Service No. 38

Address 15 Turning Mill Road

Lot #43 15 Turning Mill Road Location

Kind of Pipe Size 6"

Size of Main 8"

Repair—Renewal—New Service Valeri #1355

Location JUL ? 1969


Date	Material	Amount	Total	Date	Amount
1969 24 <sup>1</sup>	6" Transite pipe @	10.00	240.00	5-16-69	Deposit 240.00
5-29-69 87 <sup>1</sup>	6" Transite pipe				
2 <sup>1</sup>	4" Cast Iron pipe				

DATE \_\_\_\_\_

# TOWN OF LEXINGTON — BOARD OF PUBLIC WORKS

## SEWER DIVISION

Sketch of Service Here **15**

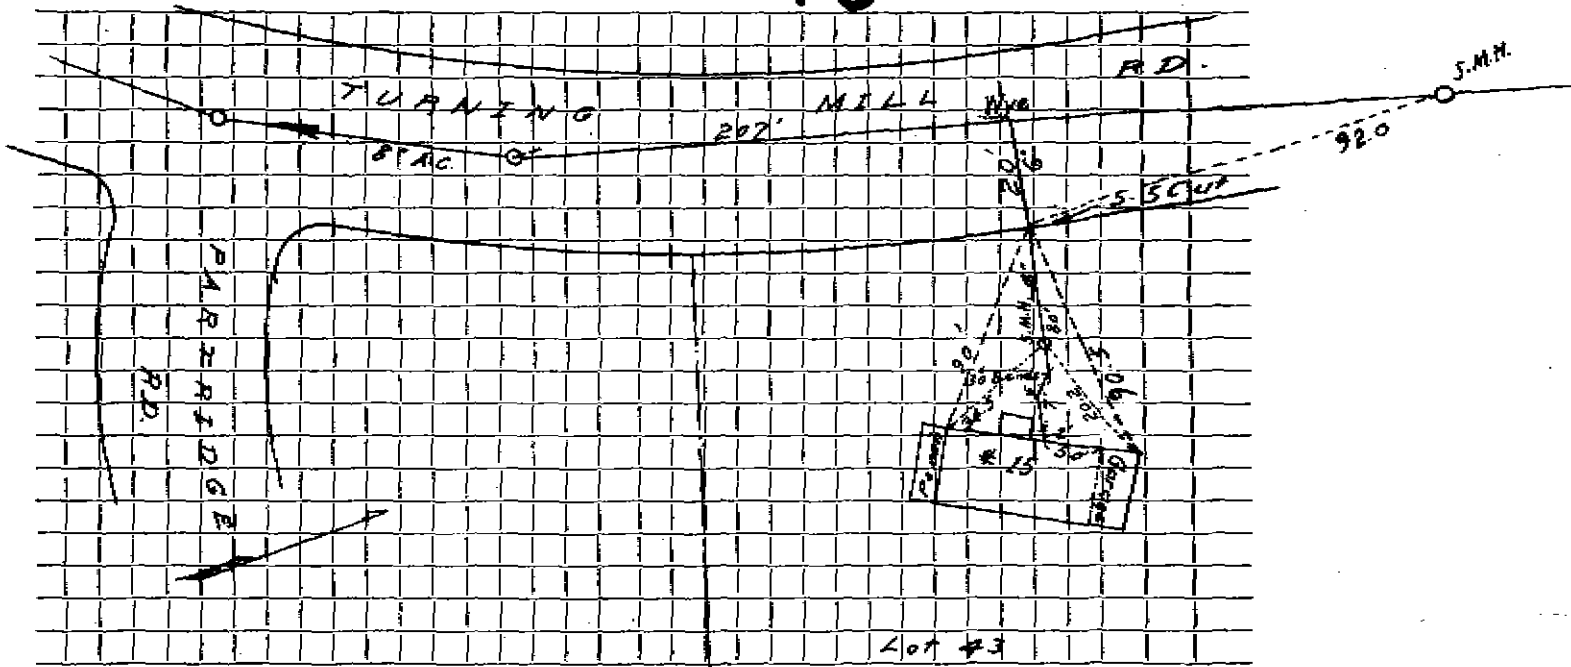

Connection made in ..... Street. Work completed .....

Remarks: .....  
.....  
.....